# CONTRACT DRAWINGS FOR CONSTRUCTION OF **MOUNTAIN & LAKE LOOP SHORELINE STABILIZATION CHERRY CREEK BASIN WATER QUALITY AUTHORITY JULY 2012**

### **RECORD DRAWING**

### 7/15/13

THIS RECORD DRAWING HAS BEEN PREPARED, IN PART, BASED UPON INFORMATION FURNISHED BY OTHERS. WHILE THIS INFORMATION IS BELIEVED TO BE RELIABLE, MULLER ROINEERING COMPANY, INC. CANNOT ASSURE ITS ACCURACY, AND THUS IS NOT RESPONSIBLE FOR THE ACCURACY OF THIS ECORD DRAWING OR FOR ANY ERRORS OR OMISSIONS WHICH MAY HAVE BEEN INCORPORATED INTO IT AS A RESULT, THOSE RELYING ON THIS RECORD DRAWING ARE ADVISED TO OBTAIN INDEPENDENT VERIFICATION OF ITS ACCURACY BEFORE APPLYING IT FOR ANY PURPOSE.

# **ADAMS** JEFFERSON ARAPAHOE **DOUGLAS** PROJECT LOCATION AS SHOWN ON THE LOCATION MAP, THIS SHEET. MILES

### **VICINITY MAP**

HORIZONTAL CONTROL FROM ARAPAHOE COUNTY CONTROL POINTS. VERTICAL CONTROL FROM BM 3" BRASS CAP @NW CORNER OF HEADWALL ON SOUTH END OF NEWARK WAY CUL-DE-SAC. NORTH OF COTTONWOOD CREEK STAMPED: "USGS. SEPT. 1992 ELEV. 5632.33". NGVD 1929 DATUM.

THIS **GRADING. EROSION AND SEDIMENT CONTROL (GESC)** DOCUMENT HAS BEEN PLACED IN THE ARAPAHOE COUNTY FILE FOR THIS PROJECT AND APPEARS TO FULFILL THE LATEST VERSION OF THE ARAPAHOE COUNTY GRADING, EROSION AND SEDIMENT CONTROL MANUAL ADDITIONAL GRADING. EROSION AND SEDIMENT CONTROL MEASURES MAY BE REQUIRED OF THE OWNER OR HIS/HER AGENTS, DUE TO UNFORESEEN EROSION PROBLEMS OR IF THE SUBMITTED GESC PLAN DOES NOT FUNCTION AS INTENDED. THE REQUIREMENTS OF THIS GESC PLAN SHALL RUN WITH THE LAND AND BE THE OBLIGATION OF THE LAND OWNER, OR HIS/HER DESIGNATED REPRESENTATIVE(S) UNTIL SUCH TIME AS THE PLAN IS PROPERTY COMPLETED, MODIFIED OR VOIDED


ARAPAHOE COUNTY CASE

NUMBER: E11-009

7/2012 FIELD CONDITIONS PRIOR TO BID 7/15/13 AS-BUILT INFORMATION ALR APPR. MEC PROJECT No. 08025.02

THESE GESC PLANS HAVE BEEN REVIEWED BY ARAPAHOE COUNTY FOR GRADING, EROSION AND SEDIMENT CONTROL IMPROVEMENTS ONLY.

FOR AND ON BEHALF OF THE ARAPAHOE COUNTY DEPARTMENT OF PUBLIC WORKS AND DEVELOPMENT

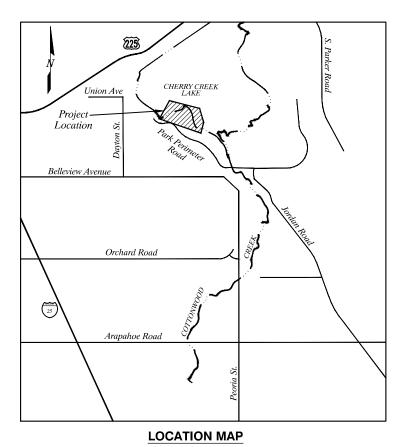

I HEREBY ATTEST THAT THIS GRADING, EROSION AND SEDIMENT CONTROL (GESC) DOCUMENT FOR THE MOUNTAIN & LAKE LOOP SHORELINE STABILIZATION HAS BEEN PREPARED BY ME OR UNDER MY DIRECT SUPERVISION, AND TO THE BEST OF MY KNOWLEDGE AND ABILITY HAS BEEN PREPARED IN ACCORDANCE WITH THE LATEST VERSION OF THE ARAPAHOE COUNTY GESC MANUAL. THE SIGNATURE AND STAMP AFFIXED HEREON CERTIFIES THAT THIS GESC DOCUMENT WAS PREPARED IN ACCORDANCE WITH THE REQUIRED REGULATIONS AND CRITERIA; HOWEVER, THE STAMP AND SIGNATURE DO NOT CERTIFY OR GUARANTEE FUTURE PERFORMANCE OF THE EXECUTION OF THE PLAN BY THE CONTRACTOR. THE CONTRACTOR IS RESPONSIBLE FOR EXECUTING THE CONSTRUCTION WORK ACCORDING TO THE INFORMATION SET FORTH IN THE PLAN AND IN ACCORDANCE WITH ALL APPLICABLE REQUIREMENTS.

REGISTERED PROFESSIONAL ENGINEER

STATE OF COLORADO NO.

I HEREBY CERTIFY THAT THE GRADING, EROSION AND SEDIMENT CONTROL (GESC) MEASURES FOR THE MOUNTAIN & LAKE LOOP SHORELINE STABILIZATION SHALL BÉ CONSTRUCTED ACCORDING TO THE DESIGN PRESENTED IN THIS REPORT. I UNDERSTAND THAT ADDITIONAL EROSION CONTROL. SEDIMENT CONTROL AND WATER QUALITY ENHANCING MEASURES MAY BE REQUIRED OF THE OWNER AND HIS OR HER AGENTS DUE TO UNFORSEEN POLLUTANT DISCHARGES OR IF THE SUBMITTED PLAN DOES NOT FUNCTION AS INTENDED. THE REQUIREMENTS OF THE PLAN SHALL BE THE OBI IGATION OF THE LAND OWNER AND/OR HIS SUCCESSORS OR HEIRS; UNTIL SUCH TIME AS THE PLAN IS PROPERLY COMPLETED, MODIFIED OR VOIDED.

OWNER OR AUTHORIZED AGENT

AUTHORIZED SIGNATURE

### **MOUNTAIN & LAKE LOOP** SHORELINE STABILIZATION **CHERRY CREEK BASIN WATER QUALITY AUTHORITY**

### **INDEX OF DRAWINGS**

SHEET	DRAWING NO.	TITLE
	GENERAL	
1	G-1	TITLE SHEET
2	G-2	GENERAL NOTES
3	G-3	SITE PLAN
	CIVIL	
4	C-1	GRADING AND STABILIZATION PLAN A
5	C-2	GRADING AND STABILIZATION PLAN B
6	C-3	GRADING AND STABILIZATION PLAN C
7	C-4	GRADING AND STABILIZATION PLAN D
8	C-5	GRADING AND STABILIZATION PLAN E
9	C-6	GRADING AND STABILIZATION PLAN F
10	C-7	MOUNTAIN LOOP GRADING PLAN
11	C-8	BOARDWALK DETAILS
12	C-9	CONSTRUCTION DETAILS
13	C-10	CONSTRUCTION DETAILS
14	C-11	CONSTRUCTION DETAILS
15 16	C-12 C-13	CONSTRUCTION DETAILS
16		TRENCH DRAIN DETAILS
	LANDSCAPE	
17	L-0	LANDSCAPE PLANS - NOTES, LEGENDS & PLANTING SCHEDULE
18	L-1	LANDSCAPE PLANS - PLAN A
19	L-2	LANDSCAPE PLANS - PLAN B
20	L-3	LANDSCAPE PLANS - PLAN C
21	L-4	LANDSCAPE PLANS - PLAN D
22	L-5	LANDSCAPE PLANS - PLAN E
23	L-6	LANDSCAPE PLANS - PLAN F
24	L-7	PICNIC TERRACE ENLARGEMENT - PLAN G
25	L-8	SITE DETAILS
26	L-9	LANDSCAPE DETAILS
	GESC PLANS	
27	EC-1	GESC PLAN INDEX
28	EC-2	GESC PLAN A
29	EC-3	GESC PLAN B
30	EC-4	GESC PLAN C
31	EC-5	GESC PLAN D
32	EC-6	GESC STANDARD NOTES AND DETAILS (1 OF 3)
33	EC-7	GESC STANDARD NOTES AND DETAILS (2 OF 3)
34	EC-8	GESC STANDARD NOTES AND DETAILS (3 OF 3)

## **CHERRY CREEK BASIN WATER QUALITY AUTHORITY**

BILL RUZZO; TECHNICAL MANAGER

### **COLORADO STATE PARKS**

Colorado State Parks

SHAWN KRIER; PROJECT MANAGER

TIM METZGER; PARK MANAGER

**GENERAL** JULY 2011 **COVER SHEET** 

G-1 1 OF 34

DATE

DATE

DATE

MULLER ENGINEERING CO., INC. CONSULTING ENGINEERS

LAKEWOOD, COLORADO 802

MDC AI M

CHERRY CREEK BASIN WATER QUALITY AUTHORITY 8390 E. CRESCENT PKWY., SUITE 500 GREENWOOD VILLAGE, CO. 80111

### **GENERAL LEGEND**

5585.75

\* \* \*

FC25-E

CA

(CWA)

(SCL

( SM

SF

(SSA)

(sc)

(SP

(VTC)

(LOC)

(ECB)

(RP

CF

SOIL/SUBGRADE

EXISTING SHRUBS

NEW EMBANKMENT

SPOT ELEVATION

PROPOSED FENCE

**FASEMENTLINE** 

RIGHT-OF-WAY

**EXISTING RIPRAP** 

PROPOSED RIPRAP

CONSTRUCTION ACCESS

CONCRETE WASHOUT AREA

SEDIMENT CONTROL LOG

SEEDING AND MULCHING

STABILIZED STAGING AREA

VEHICLE TRACKING CONTROL

LIMITS OF CONSTRUCTION

**EROSION CONTROL BLANKET** 

CONSTRUCTION FENCE

SILT CURTAIN

STOCKPILES

RIPRAP PAD

— — — ← EXISTING CULVERTS

--\*--\* EXISTING FENCE

GEOTECHNICAL TEST PIT

SLOPE AS INDICATED (HORIZ:VERT)

-SECTION OR DETAIL DESIGNATION

DETAIL IS SHOWN OR TAKEN

EXISTING MAJOR CONTOUR

EXISTING MINOR CONTOUR

PROPOSED MAJOR CONTOUR

PROPOSED MINOR CONTOUR

**EDGE OF PAVEMENT/CONCRETE** 

DRAWING NUMBER WHERE SECTION OR

CONCRETE

### **TIONS**

INV

L.P.

MH

MID

MIN.

NRCF

N.T.S.

PC

PT

PVI

PVC

PSF

PSI

QTY.

**RCP** 

REV.

R.O.W.

SPEC.

SQ.

STA

STD.

STL

SS

TOC

TOG

TOW

TYP.

U.G.

U/S

W/O

WQ

WS

WSE

U.S.G.S.

VERT. OR V

SAN SEWER

REO'D

RAD, OR R

**RET WALL** 

# OR NO.

O/C. OR O.C.

-REINFORCED CONCRETE PIPE

-REQUIRED

-RETAINING WALL

-RIGHT OF WAY

-SPECIFICATION

-SANITARY SEWER

-STAINLESS STEEL

-TOP OF CURB

-TOP OF WALL

-UPSTREAM

-VERTICAL

-WITHOUT

-WITH

-TYPICAL

-TOP OF GROUT

-UNDERGROUND

-UNITED STATES

-WATER QUALITY

-WATER SURFACE

-WATER SURFACE ELEVATION

GEOLOGICAL SURVEY

-SQUARE

-STATION

-STEEL

-STANDARD

-REVISED OR REVISION

-RADIUS

SCH. OR SCHED. -SCHEDULE

	ABBREVIA
AF	-ACRE - FEET
APPROX.	-APPROXIMATELY
@	-AT
BLDG.	-BUILDING
BLDR	-BOULDER
BOC.	-BACK OF CURB
BOW	-BOTTOM OF WALL
BP	-BANK PROTECTION
BTWN	-BETWEEN
<b>©</b>	-CENTERLINE
C.O.	-CLEAN OUT
CDOT	-COLORADO DEPARTMEN OF TRANSPORTATION
CLR.	-CLEAR
COMB.	-COMBINATION
CONC. CF	-CONCRETE
CF	-CUBIC FEET
	-CONSTRUCTION JOINT
DET. DIA. OR Ø	-DETAIL
DIA. OR Ø	-DIAMETER
DIM. DIP	-DIMENSION
	-DUCTILE IRON PIPE
D/S DWG.	-DOWNSTREAM
EA.	-DRAWING -EACH
EW.	
EOP	-EACH WAY -EDGE OF PAVEMENT
EOW	-EDGE OF PAVEMENT
EL.	-ELEVATION
EXST.	-ELEVATION -EXISTING
FES	-FLARED END SECTION
FL	-FLOW LINE
FT.	-FEET OR FOOT
F.F/FF	-FINISHED FLOOR
FS	-FIRE SERVICE
GV	-GATE VALVE
GALV.	-GALVANIZED
GALV.	-GALVANIZED -GAS
HC	-HANDICAP
HE.	-HORIZONTAL ELLIPTICAL
H.P.	-HIGH POINT
	HHORIZONTAL
HT.	-HEIGHT

		GENERAL NOTES
-INCH -INVERT ELEVATION -LINEAR FOOT/FEET -LOW POINT -MANHOLE -MAXIMUM -MIDDLE -MINIMUM -NONREINFORCED CONCRETE PIPE -NOT TO SCALE	1.	LOCATIONS OF UTILITIES REPRESENT THE BEST-KNOWN LOCATIONS AT THE TIME OF PREPARATION OF DRAWINGS. THE CONTRACTOR SHALL FIELD-LOCATE ALL UTILITIES IN ADVANCE OF EXCAVATION. RELOCATION OF UTILITIES MAY OR MAY NOT BE NEEDED AFTER THEY ARE EXPOSED. ACTUAL RELOCATION OF LINES WILL NOT BE THE RESPONSIBILITY OF THE CONTRACTOR, UNLESS OTHERWISE SHOWN, BUT THE CONTRACTOR SHALL COOPERATE WITH UTILITY COMPANIES TO COORDINATE THE RELOCATION EFFORT. LINES NOT RELOCATED SHALL BE PROTECTED BY THE CONTRACTOR IN PLACE OR REMOVED AND REPLACED, IN KIND, AS APPROVED BY THE ENGINEER. NO ADDITIONAL PAYMENT WILL BE ALLOWED FOR THE MINOR ADJUSTMENT OF STRUCTURES OR PIPES IN ORDER TO CLEAR A CONFLICTING UTILITY. CONTACT UTILITY COMPANIES 48 HOURS IN ADVANCE WHEN WORKING ADJACENT TO THE UTILITY.
-NUMBER -ON CENTER -POINT OF CURVATURE -POINT OF TANGENCY	2.	THE CONTRACTOR SHALL COMPLY WITH ANY APPLICABLE TRAFFIC CONTROL REQUIREMENTS OF GREENWOOD VILLAGE OR AURORA IN ACCESSING THE CONSTRUCTION SITE.
-POINT OF VERTICAL INTERSECTION -POLYVINYL CHLORIDE PIPE -POUND/ SQUARE FOOT	3.	PROJECT FACILITIES ARE TO BE LOCATED BASED ON THE SURVEY COORDINATES, ELEVATIONS, DIMENSIONS, AND/OR GEOMETRIC DESIGN DATA PROVIDED ON THE DRAWINGS. WHERE SUCH INFORMATION IS NOT INDICATED ON THE DRAWINGS, FINISHED GRADES AND FACILITY LOCATIONS ARE TO BE DERIVED FROM PLAN VIEW LAYOUT LINES AND CONTOURS.
-POUND/ SQUARE INCH -QUANTITY -RADIUS	4.	THE CONTRACTOR IS SOLELY RESPONSIBLE FOR PROVIDING STABLE EXCAVATIONS AND TEMPORARY SLOPES AND FOR SATISFYING ALL APPLICABLE

### OSHA, FEDERAL, STATE, AND LOCAL REGULATIONS. TEMPORARY EXCAVATIONS SHALL PROVIDE, AT MINIMUM, THE TRENCH DIMENSIONS AND CLEARANCES SHOWN OR SPECIFIED. TEMPORARY CONSTRUCTION SLOPES SHALL BE SLOPED SHORED, SHEETED, AND/OR BRACED IN ACCORDANCE WITH STABILITY REQUIREMENTS AND APPLICABLE REGULATIONS, AND SHALL BE NO STEEPER THAN THE SLOPES SHOWN OR SPECIFIED WITHOUT THE APPROVAL OF THE ENGINEER. ANY SUCH APPROVALS BY THE ENGINEER WILL NOT RELIEVE THE CONTRACTOR FROM SOLE RESPONSIBILITY FOR PROVIDING STABLE EXCAVATIONS AND TEMPORARY SLOPES.

- 5. THE WORK WILL TAKE PLACE IN AND AROUND A BODY OF WATER, SUBJECT TO PERIODIC FLOODING. THE CONTRACTOR SHALL BE RESPONSIBLE FOR THE CONTROL OF SURFACE AND SUBSURFACE WATER DURING THE COURSE OF THE WORK, ANY DAMAGE TO THE WORK RESULTING FROM SUBSURFACE, BASE FLOWS OR FLOOD FLOWS, INCLUDING BOUYANCY FORCES ON PIPELINES AND OTHER FACILITIES. SHALL BE CORRECTED BY THE CONTRACTOR AT THE CONTRACTOR'S SOLE COST. THE CONTRACTOR SHALL BE RESPONSIBLE FOR OBTAINING AND SATISFYING THE REQUIREMENTS OF ANY APPLICABLE PERMITS PERTAINING TO WATER AND EROSION CONTROL
- THE CONSTRUCTION WORK IS LIMITED TO THE PUBLIC RIGHT OF WAY AND THE CONSTRUCTION LIMITS SHOWN ON THE DRAWINGS.
- 7 EXISTING FACILITIES NOT INDICATED TO BE REMOVED SHALL BE PROTECTED IN PLACE OR REMOVED AND REPLACED IN KIND, AS APPROVED BY THE ENGINEER.
- 8. CONTRACTOR SHALL FIELD VERIFY THE LOCATIONS (HORIZONTAL AND VERTICAL) AT CONNECTIONS TO ALL EXISTING INFRASTRUCTURE INCLUDING EXISTING SANITARY SEWERS, STORM DRAINS AND EXISTING CONCRETE STRUCTURES. THIS INFORMATION SHALL BE COLLECTED AND SUBMITTED TO THE ENGINEER FOR REVIEW PRIOR TO FABRICATION AND/OR PRIOR TO INSTALLATION OF ANY NEW FACILITIES SHOWN ON THESE CONTRACT DRAWINGS. THE ENGINEER WILL DETERMINE IF ANY MINOR MODIFICATIONS TO THE NEW FACILITIES SHOWN ON THE CONTRACT DRAWINGS ARE NECESSARY SUCH AS HORIZONTAL AND VERTICAL
- SCALES SHOWN ARE FOR FULL SIZE (22"x34") SHEETS AND REQUIRE ADJUSTMENT FOR HALF SIZE (11"x17") SHEETS.
- 10. TOPOGRAPHIC MAPPING ON THE DRAWINGS WAS PREPARED BY CARROLL AND LANGE, INC. BASED ON A TOPOGRAPHIC SURVEY CONDUCTED IN 2009. HORIZONTAL CONTROL FROM ARAPAHOE COUNTY CONTROL POINTS. VERTICAL CONTROL FROM BM 3" BRASS CAP @NW CORNER OF HEADWALL ON SOUTH END OF NEWARK WAY CUL-DE-SAC, NORTH OF COTTONWOOD CREEK STAMPED: "USGS, SEPT. 1992 ELEV. 5632.33". NAVD 1929 DATUM.
- 11. THE FIRST INSTALLATIONS OF BANK PROTECTION AND OTHER WORK ELEMENTS IDENTIFIED BY THE OWNER SHALL BE CONSIDERED TEST INSTALLATIONS. CONTRACTOR SHALL NOTIFY ENGINEER AT LEAST 48 HOURS IN ADVANCE OF THE INSTALLATIONS SO THAT THE WORK CAN BE OBSERVED BY THE ENGINEER AND OWNER. THE OWNER, ENGINEER AND CONTRACTOR WILL DISCUSS THE WORK, CONFIRM THAT IT IS IN CONFORMANCE WITH THE DRAWINGS AND SPECIFICATIONS, AND CONSIDER ANY MODIFICATIONS THAT MAY ENABLE THE PROJECT TO BETTER EMULATE A NATURAL, FUNCTIONAL ENVIRONMENT.

### **MISCELLANEOUS MATERIAL SPECIFICATIONS**

CRUSHER FINES MATERIAL SHALL BE CRUSHED FINE MATERIAL WITH A PREDOMINANTLY GREY COLOR AND SHALL BE FREE OF STONES OVER 2" IN ANY DIMENSION, STICK, ORGANIC MATERIAL OR OTHER FOREIGN DEBRIS. THE CRUSHER FINES SHALL HAVE A SMALL ROCK MAXIMUM OF 3/8", FINES, AND DUST PRODUCED AS A BY PRODUCT OF CRUSHING ROCK. THE GRADATION SHALL BE AS FOLLOWS:

SIEVE	PERCENTAGE BY WEIGHT PASSING SQUARE
DESIGNATION	MESH SIEVES
3/8"	100
NO. 4	75 - 80
NO. 8	55 - 60
NO. 16	40 - 45
NO. 30	30
NO. 50	20
NO. 100	10 - 15
NO. 200	5 - 10

THE CONTRACTOR SHALL SUBMIT SAMPLE AND DATA SHEET TO THE OWNER FOR APPROVAL PRIOR TO INSTALLATION.

THE TOP SIX-INCHES OF TOPSOIL, IF APPLICABLE, SHALL BE STRIPPED WITHIN THE AREA TO BE SURFACED WITH CRUSHER FINES. FOLLOWING STRIPPING OF THE TOPSOIL, THE UPPER 12 INCHES OF THE SUBGRADE SHALL BE SCARIFIED AND COMPACTED TO A MINIMUM OF 95% OF THE MAXIMUM STANDARD PROCTOR DENSITY (ASTM D698). FILL SHALL BE PLACED WITHIN 2% OF OPTIMUM MOISTURE CONTENT AND COMPACTED TO A MINIMUM OF 95% OF THE MAXIMUM STANDARD PROCTOR DENSITY

THE CRUSHER FINES SHALL BE PLACED IN 2" LIFTS AND COMPACTED. IF THE MATERIAL IS TOO DRY TO READILY ATTAIN THE REQUIRED DENSITY, IT SHALL BE UNIFORMLY MOISTENED TO THE DEGREE NECESSARY DURING COMPACTION OPERATIONS FOR PROPER COMPACTION. CRUSHER FINES MATERIAL SHALL COMPACTED TO 95% OF THE MAXIMUM STANDARD PROCTOR DENSITY (ASTM D698) AND WITHIN 2% OF THE OPTIMUM MOISTURE CONTENT. EQUIPMENT USED FOR COMPACTION SHALL BE A SELF-PROPELLED VIBRATORY ROLLER COMPACTOR AND SHALL BE OF SUFFICIENT CAPACITY (MINIMUM OF 1000 POUND SINGLE DRUM ROLLER) TO MEET THE COMPACTION REQUIREMENTS HEREIN. THE SURFACE OF EACH LAYER SHALL BE MAINTAINED DURING COMPACTION OPERATIONS IN SUCH A MANNER THAT A UNIFORM TEXTURE IS PRODUCED AND AGGREGATES FIRMLY

### **RECORD DRAWING**

### 7/15/13

THIS RECORD DRAWING HAS BEEN PREPARED, IN PART, BASED UPON INFORMATION FURNISHED BY OTHERS, WHILE THIS INFORMATION IS BELIEVED TO BE RELIABLE, MULLER ROBINEERING COMPANY, INC. CANNOT ASSURE ITS ACCURACY, AND THUS IS NOT RESPONSIBLE FOR THE ACCURACY OF THIS RECORD DRAWING OR FOR ANY ERRORS OR OMISSIONS WHICH MAY HAVE BEEN INCORPORATED INTO IT AS A RESULT. THOSE RELYING ON THIS RECORD DRAWING ARE ADVISED TO OBTAIN INDEPENDENT VERIFICATION OF ITS ACCURACY BEFORE APPLYING IT FOR ANY PURPOSE.

### PROJECT TEAM

CIVIL ENGINEER: MULLER ENGINEERING COMPANY, INC.

777 S WADSWORTH BOULEVARD, #4-100 LAKEWOOD, CO 80226-4355

PHONE: 303-988-4939 FAX: 303-988-4969

LANDSCAPE ARCHITECT: WENK ASSOCIATES, INC.

MDC

AI M

CHEC

1335 ELATI STREET DENVER, CO 80204 PHONE: 303-628-0003 FAX: 303-628-0004

**ECOLOGIST** THE RESTORATION GROUP, INC. 5858 WOODBOURNE HOLLOW ROAD

> BOULDER, CO 80301 PHONE: 303-530-1783 FAX: 303-581-9219

**ERO RESOURCES CORPORATION** 1842 CLARKSON STREET **DENVER, CO 80218** 

PHONE: 303-830-1188 FAX: 303-830-1199

7/2012 FIELD CONDITIONS PRIOR TO BID 7/15/13 AS-BUILT INFORMATION ALR 4ULLEI APPR. MEC PROJECT No. 08025 02

MULLER ENGINEERING CO., INC. CONSULTING ENGINEERS

PERMITTING:

LAKEWOOD, COLORADO 802




CHERRY CREEK BASIN WATER QUALITY AUTHORITY 8390 E. CRESCENT PKWY., SUITE 500 GREENWOOD VILLAGE, CO. 80111 303-779-4525

**MOUNTAIN & LAKE LOOP** SHORELINE STABILIZATION **CHERRY CREEK BASIN WATER QUALITY AUTHORITY**  **GENERAL** 


**GENERAL NOTES** 


JULY 2011 G-2

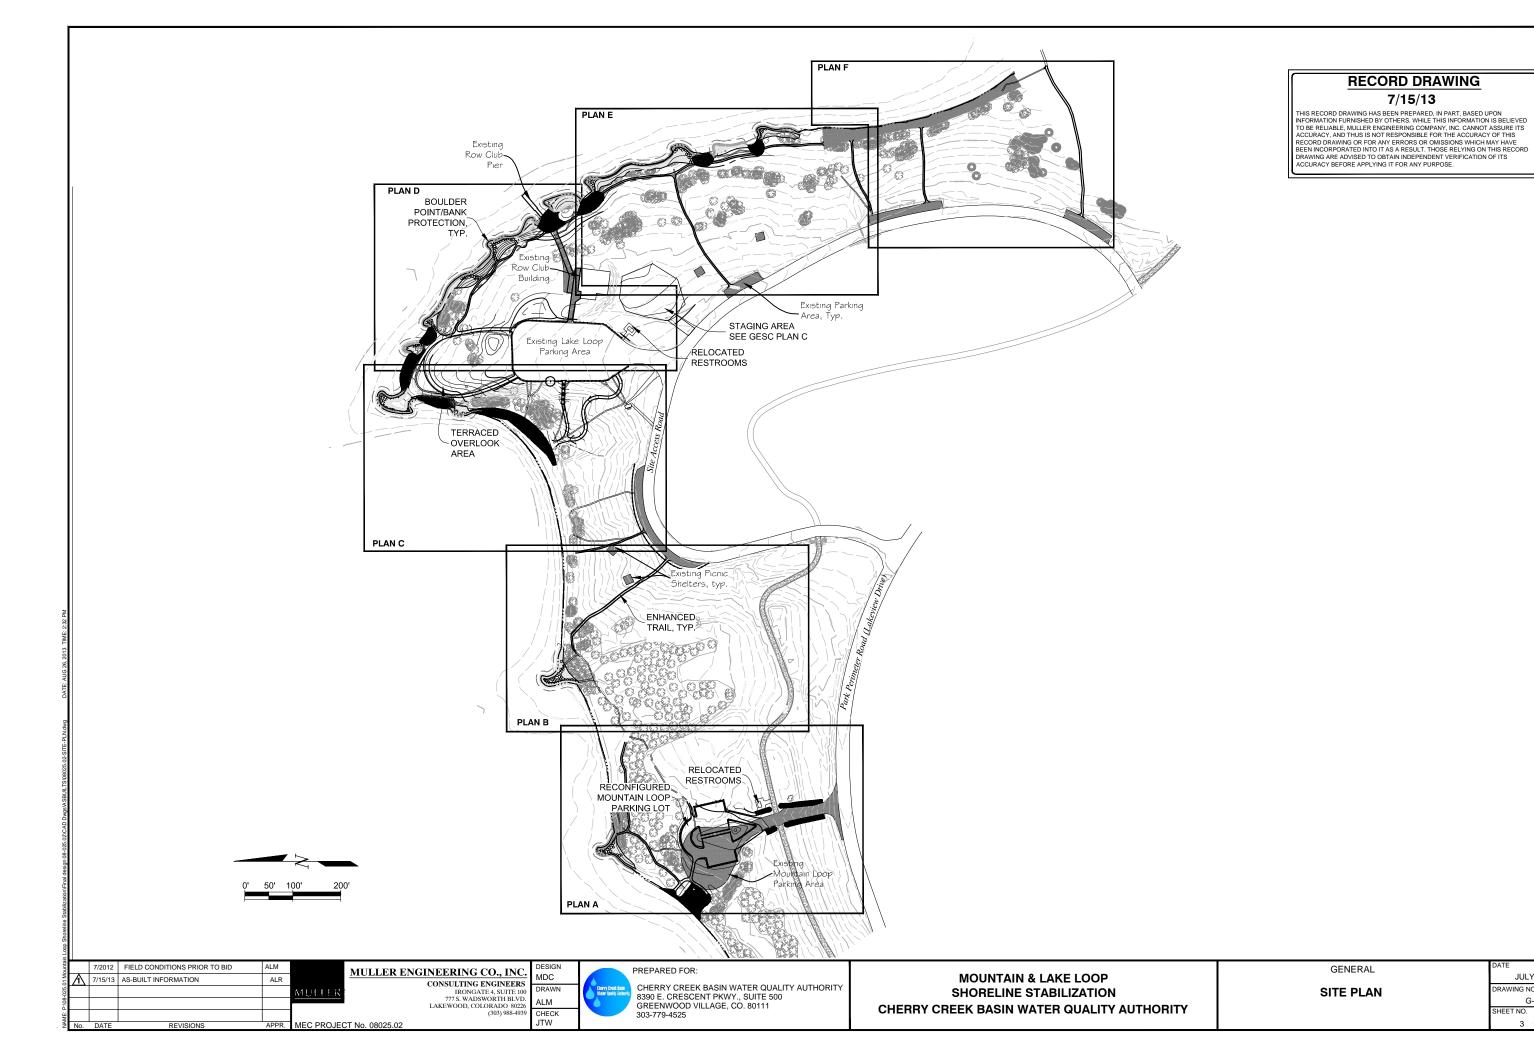



JULY 2011


G-3

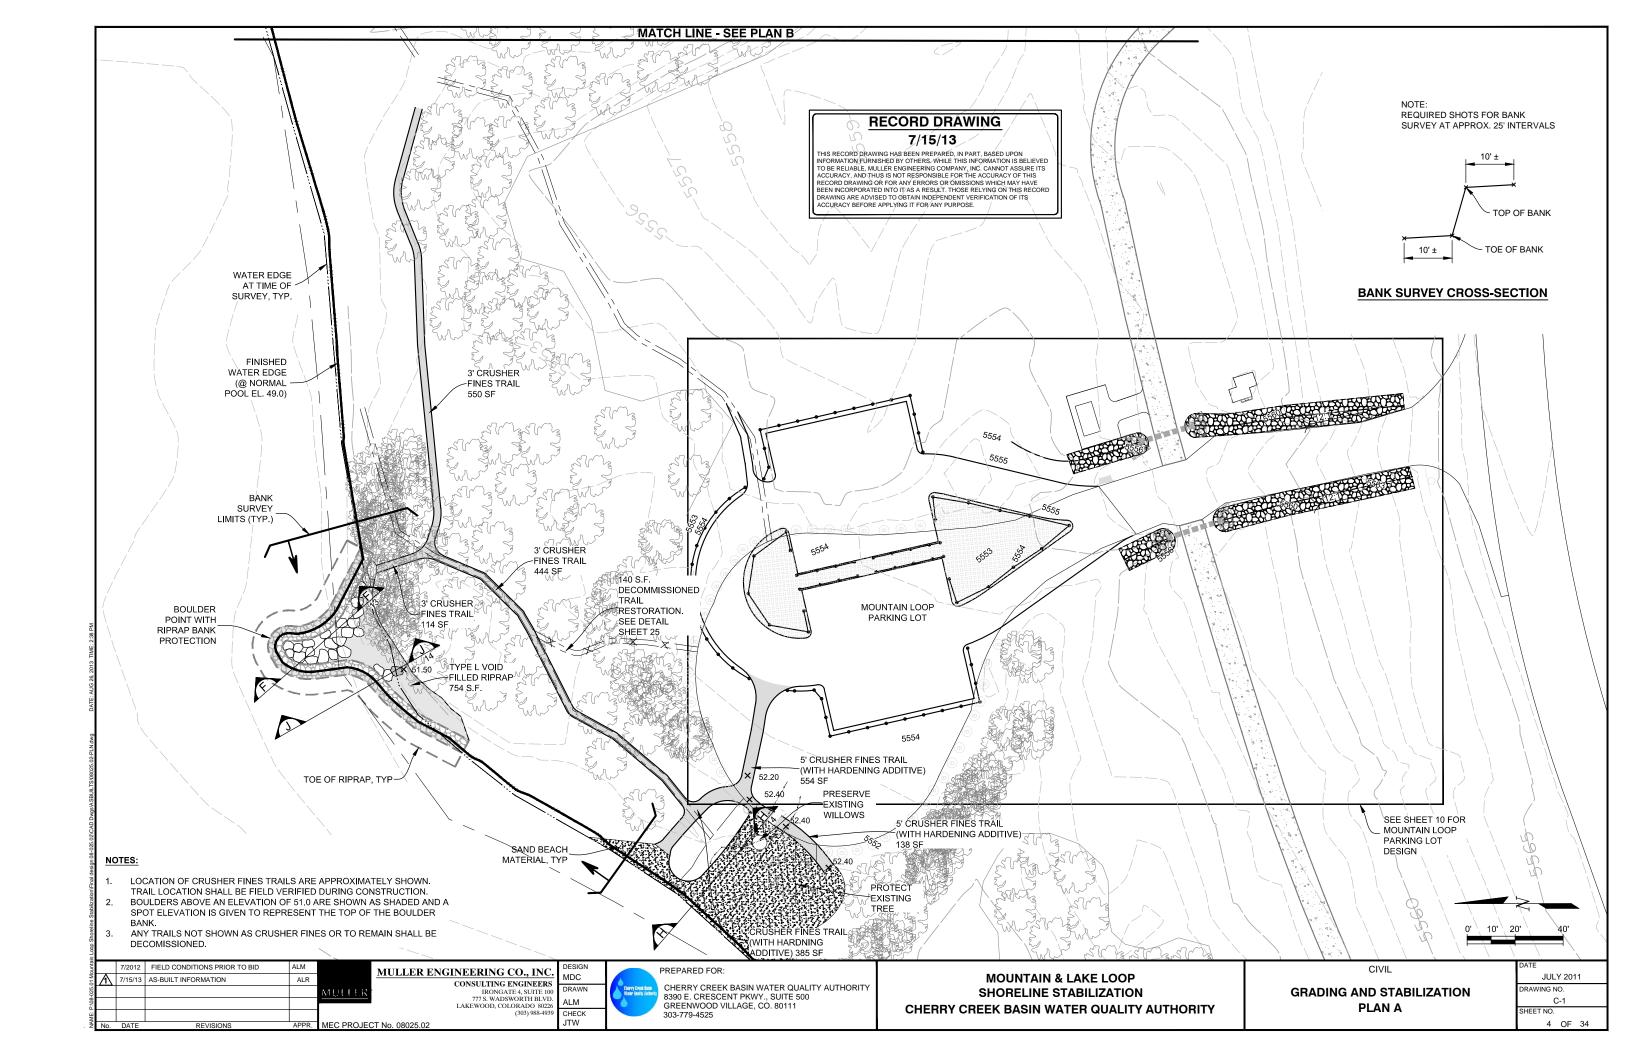


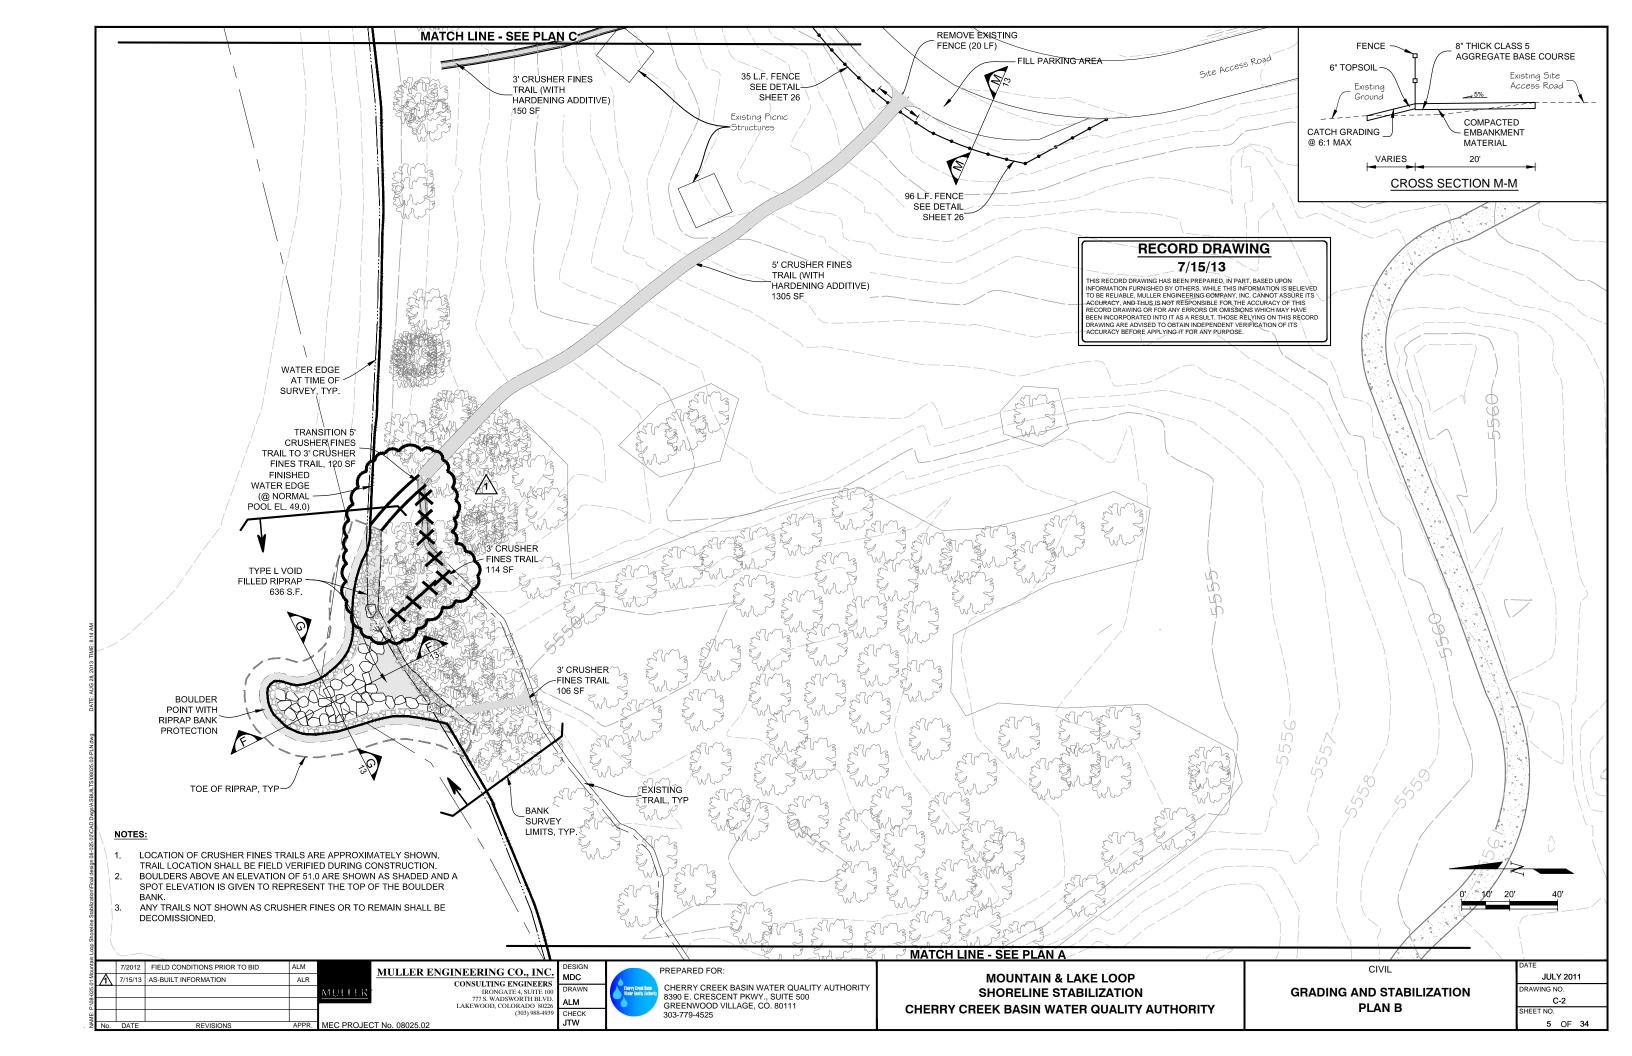


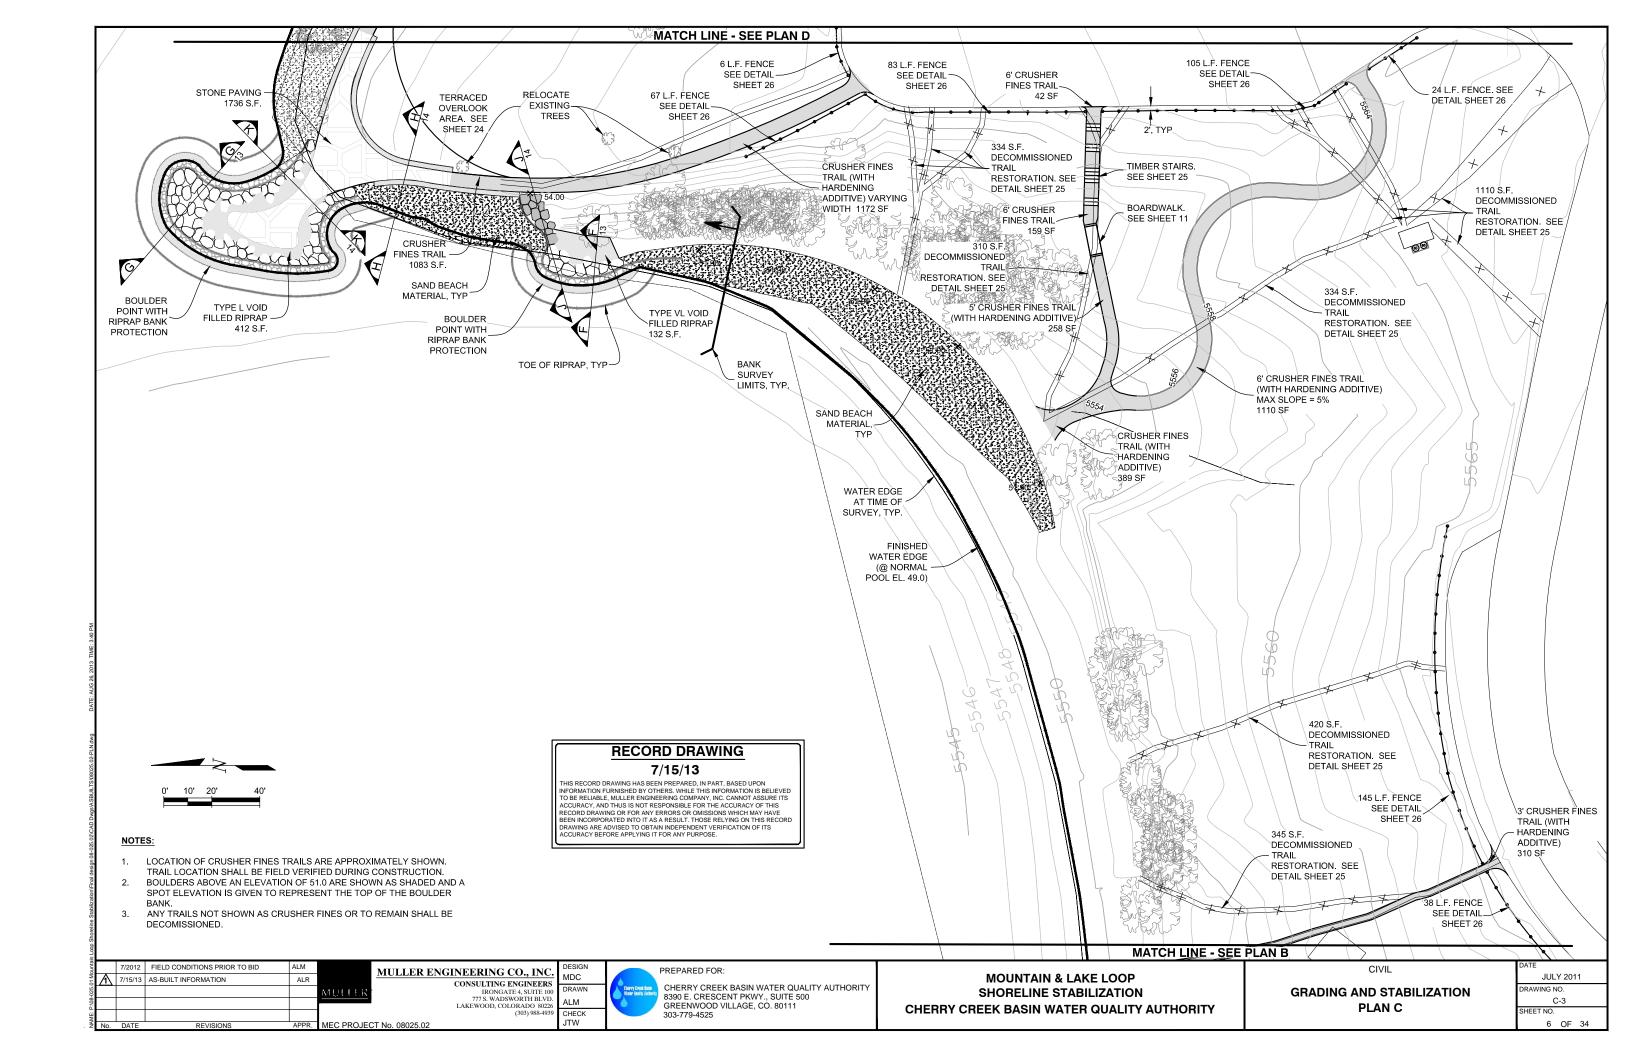


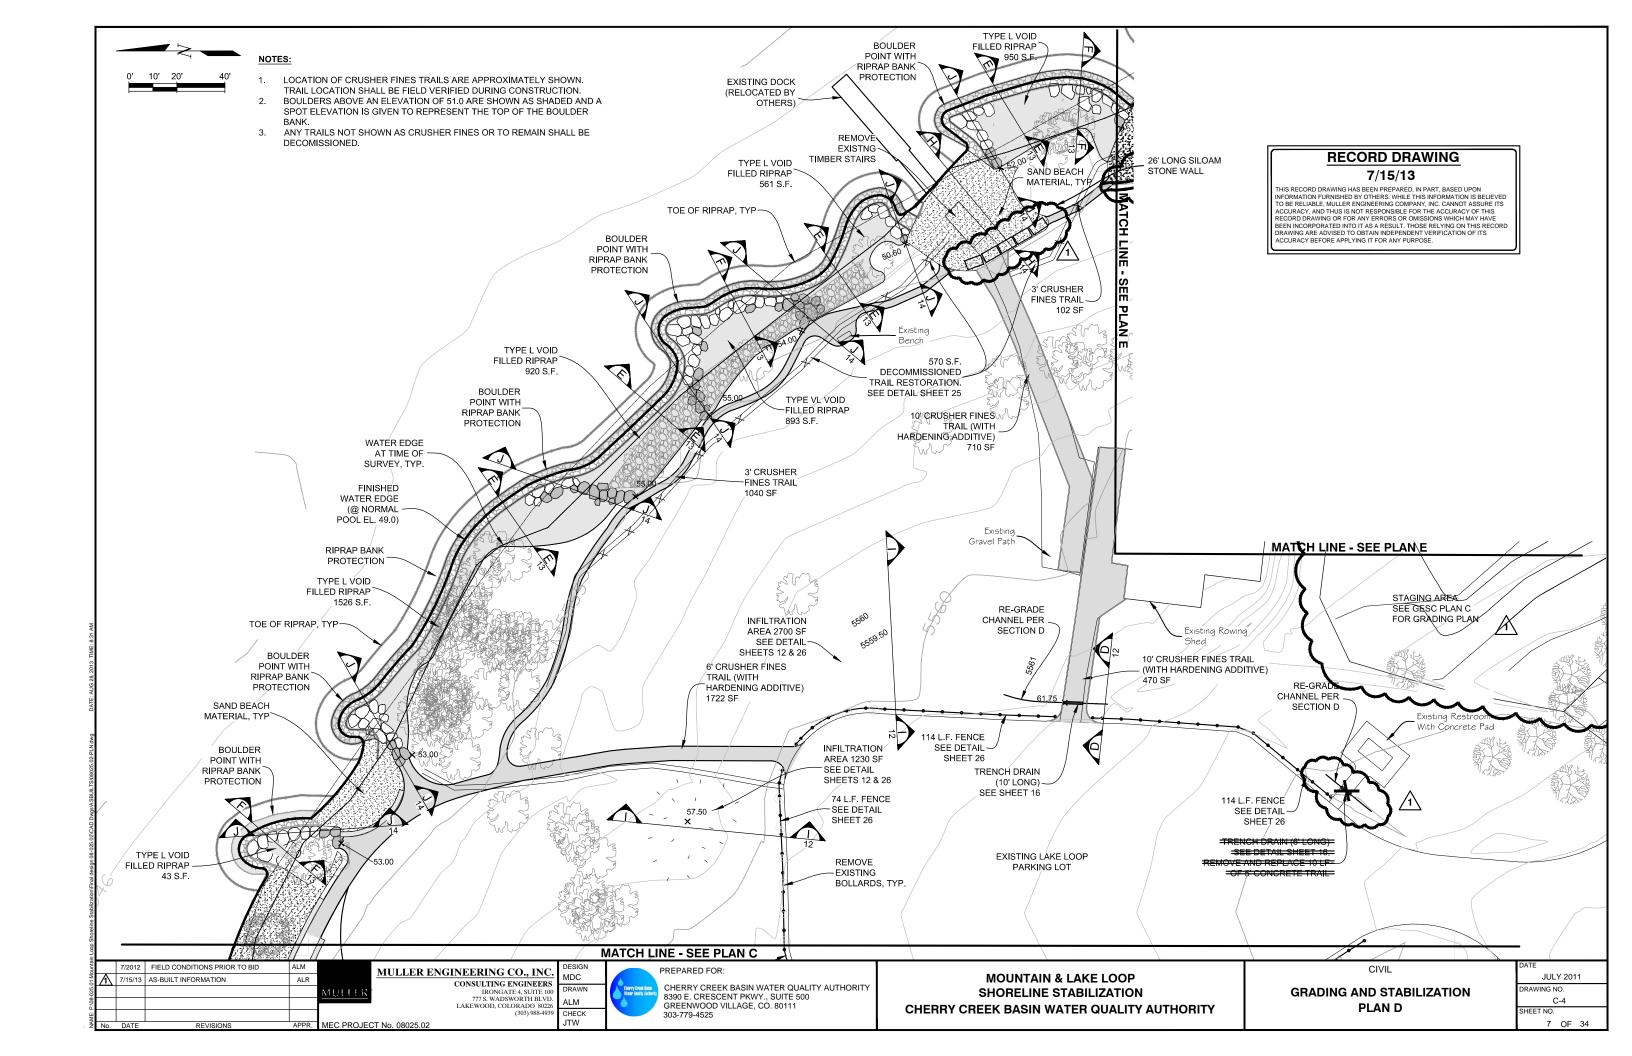


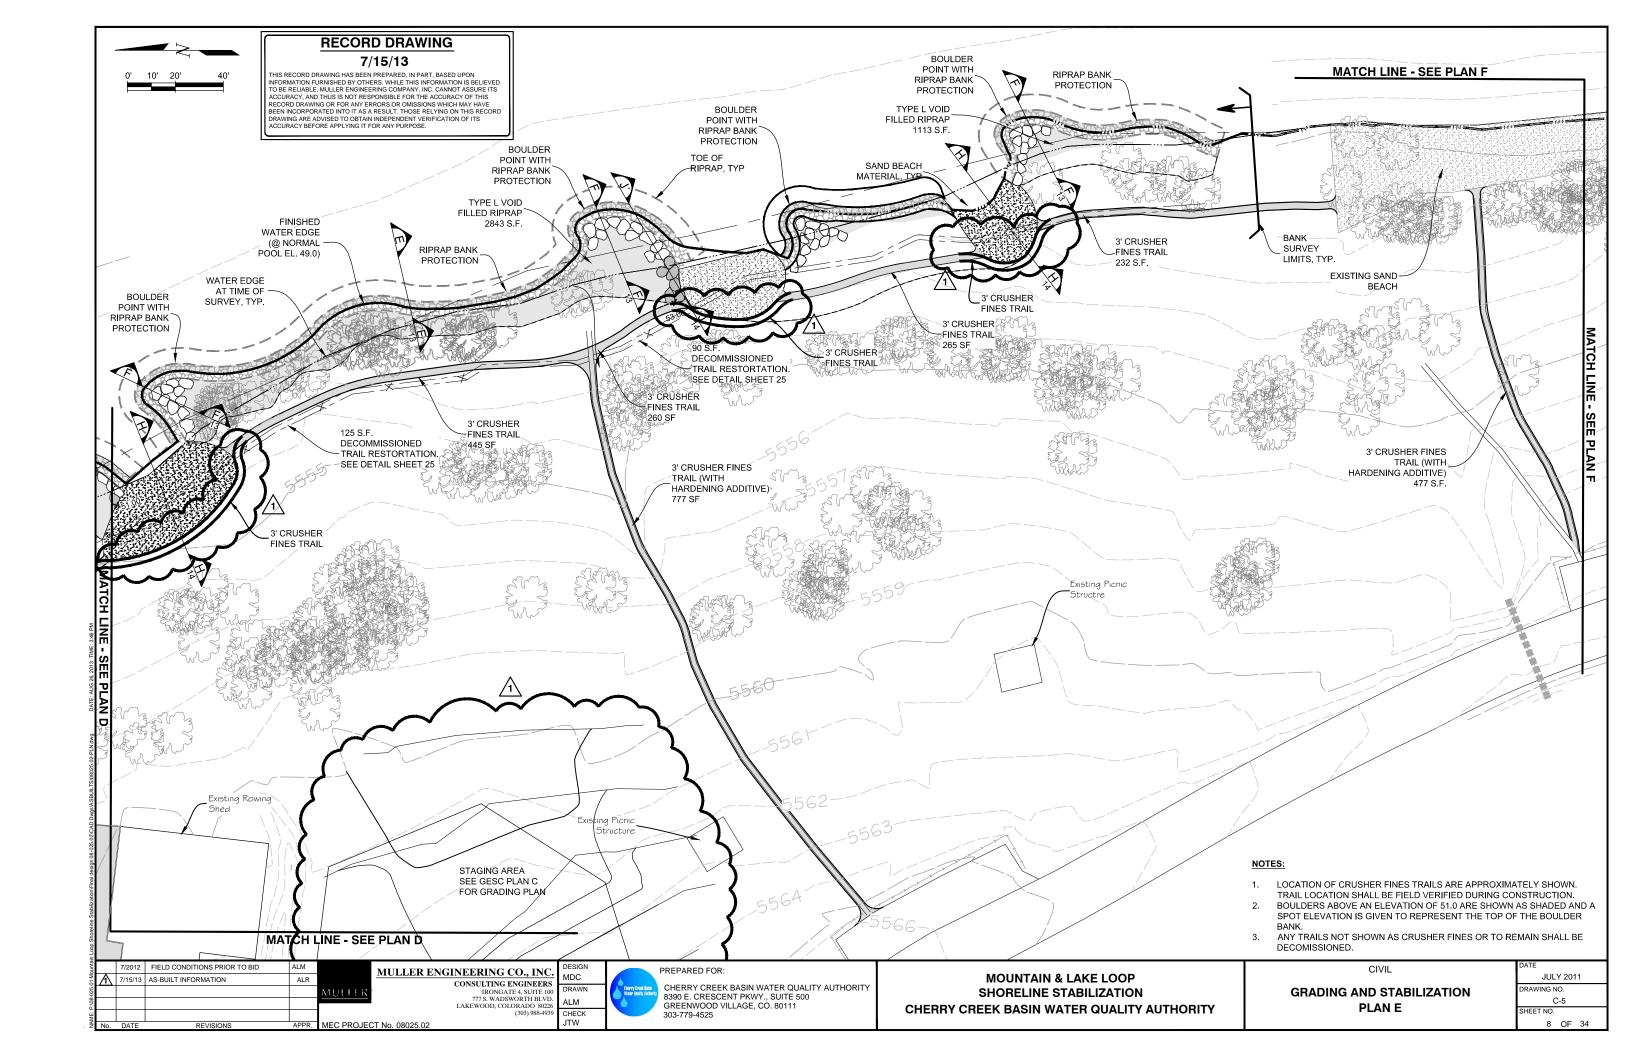


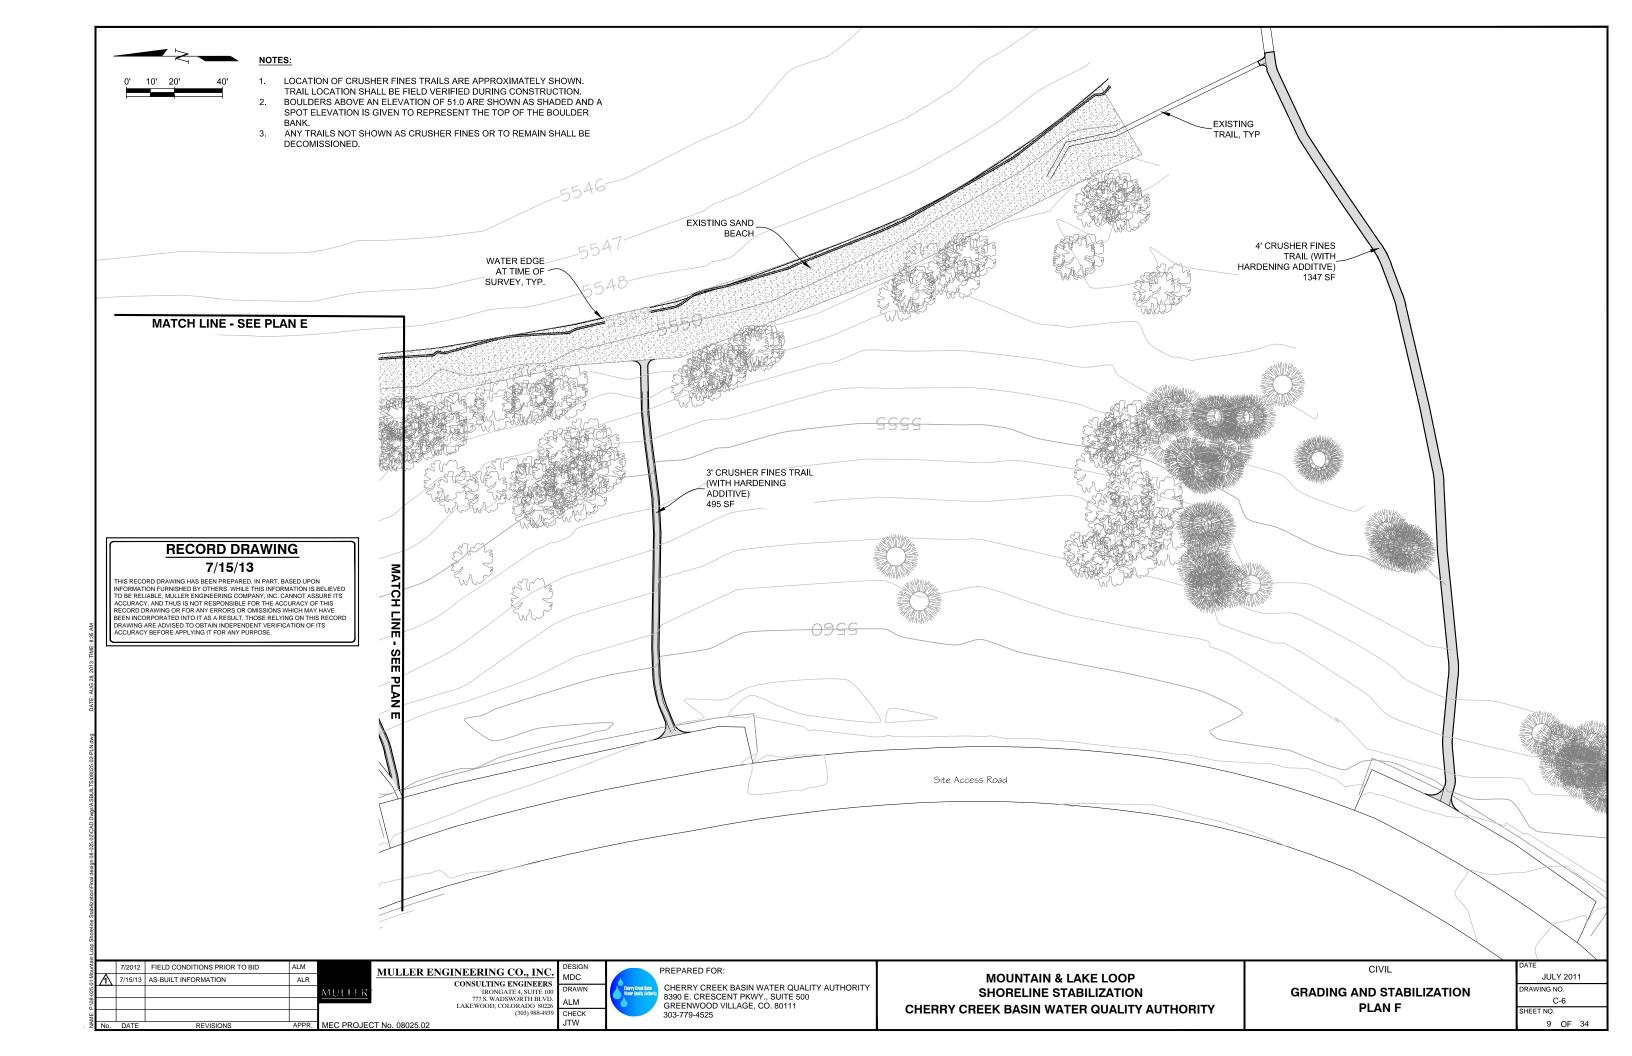


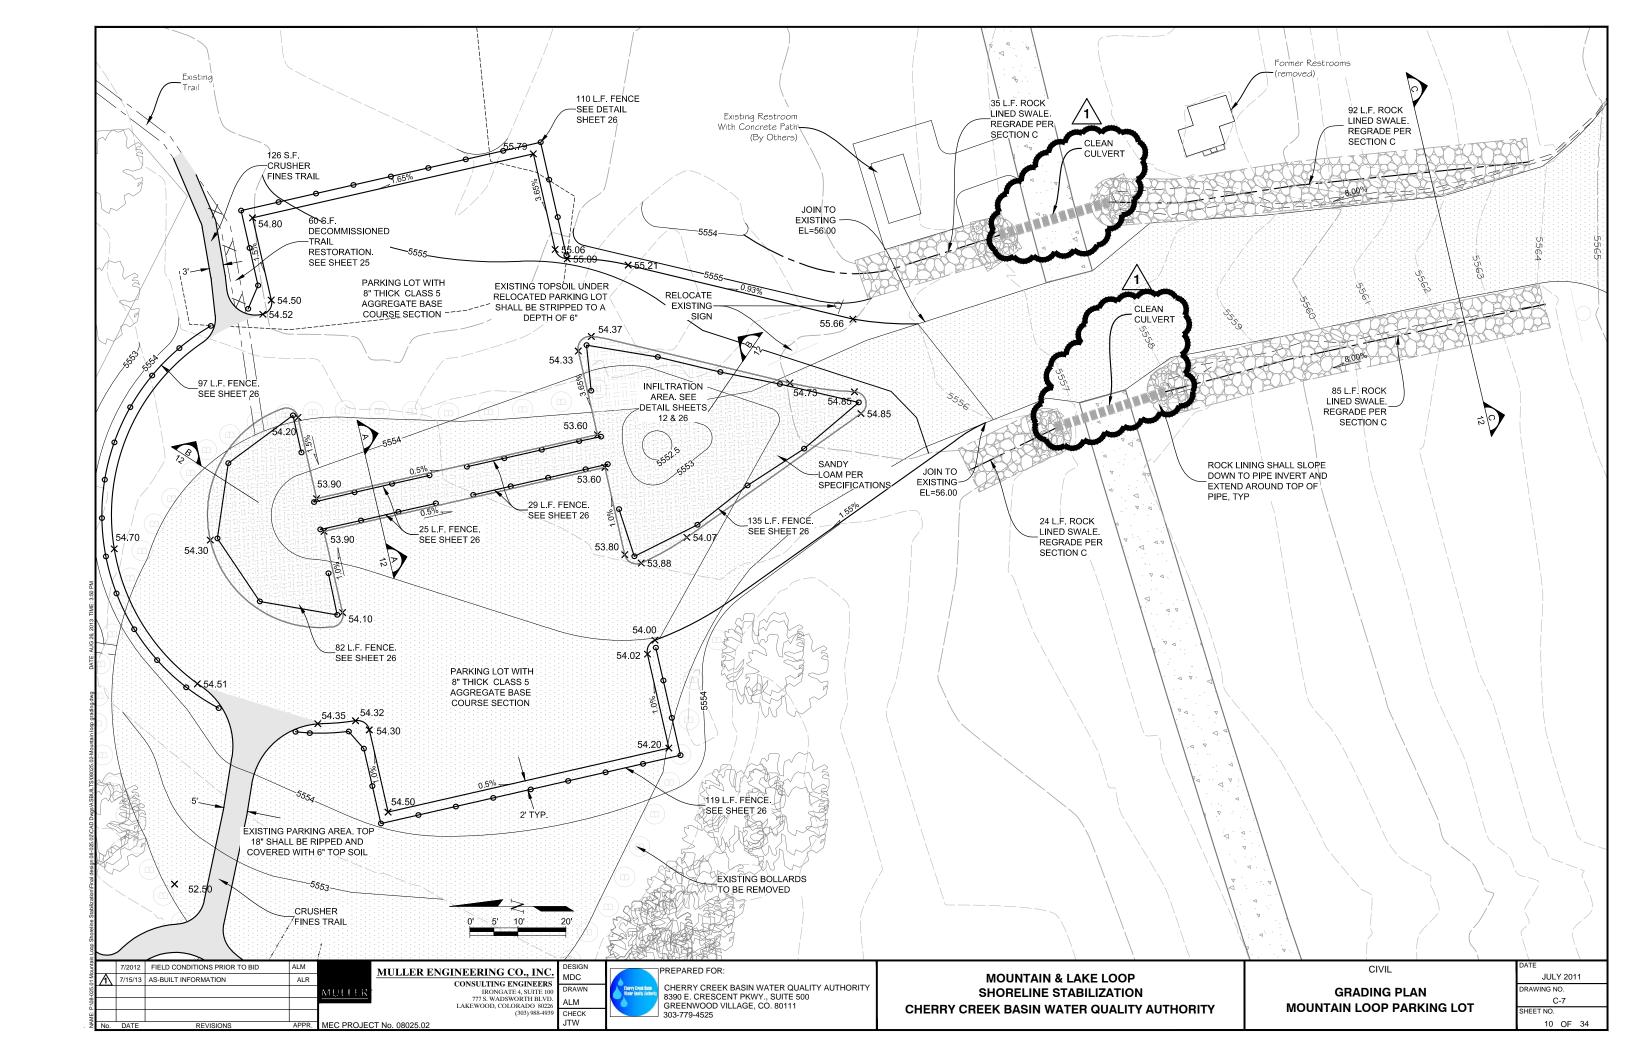

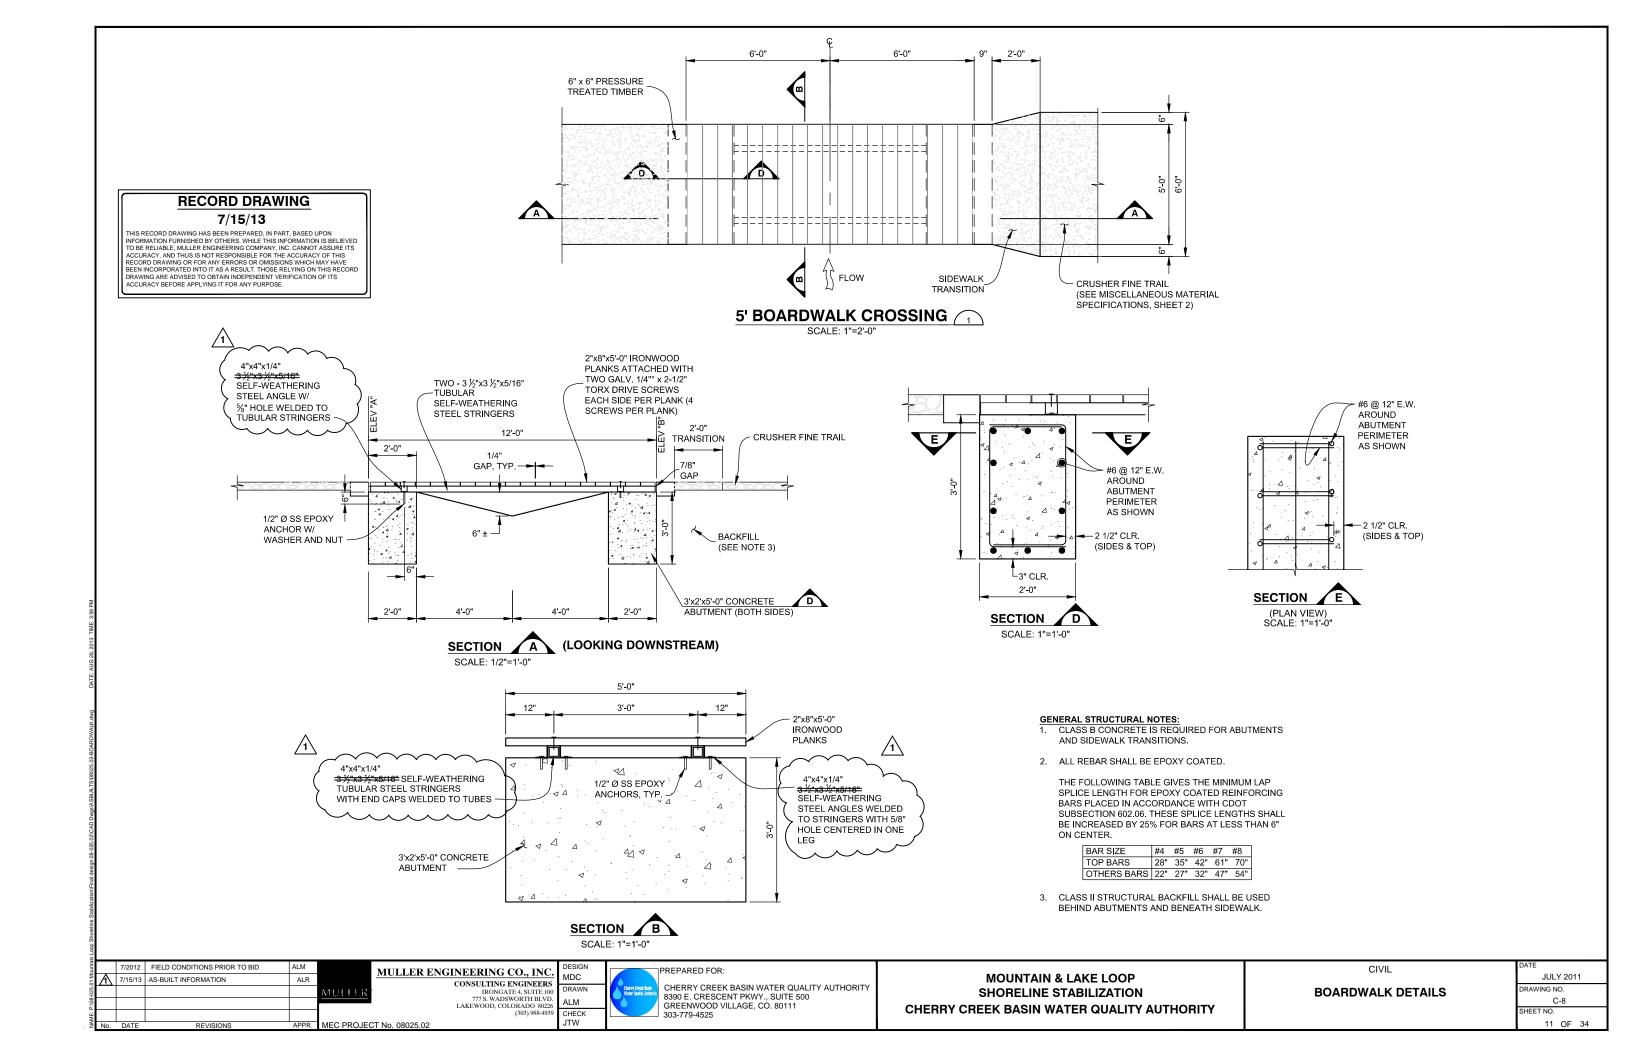

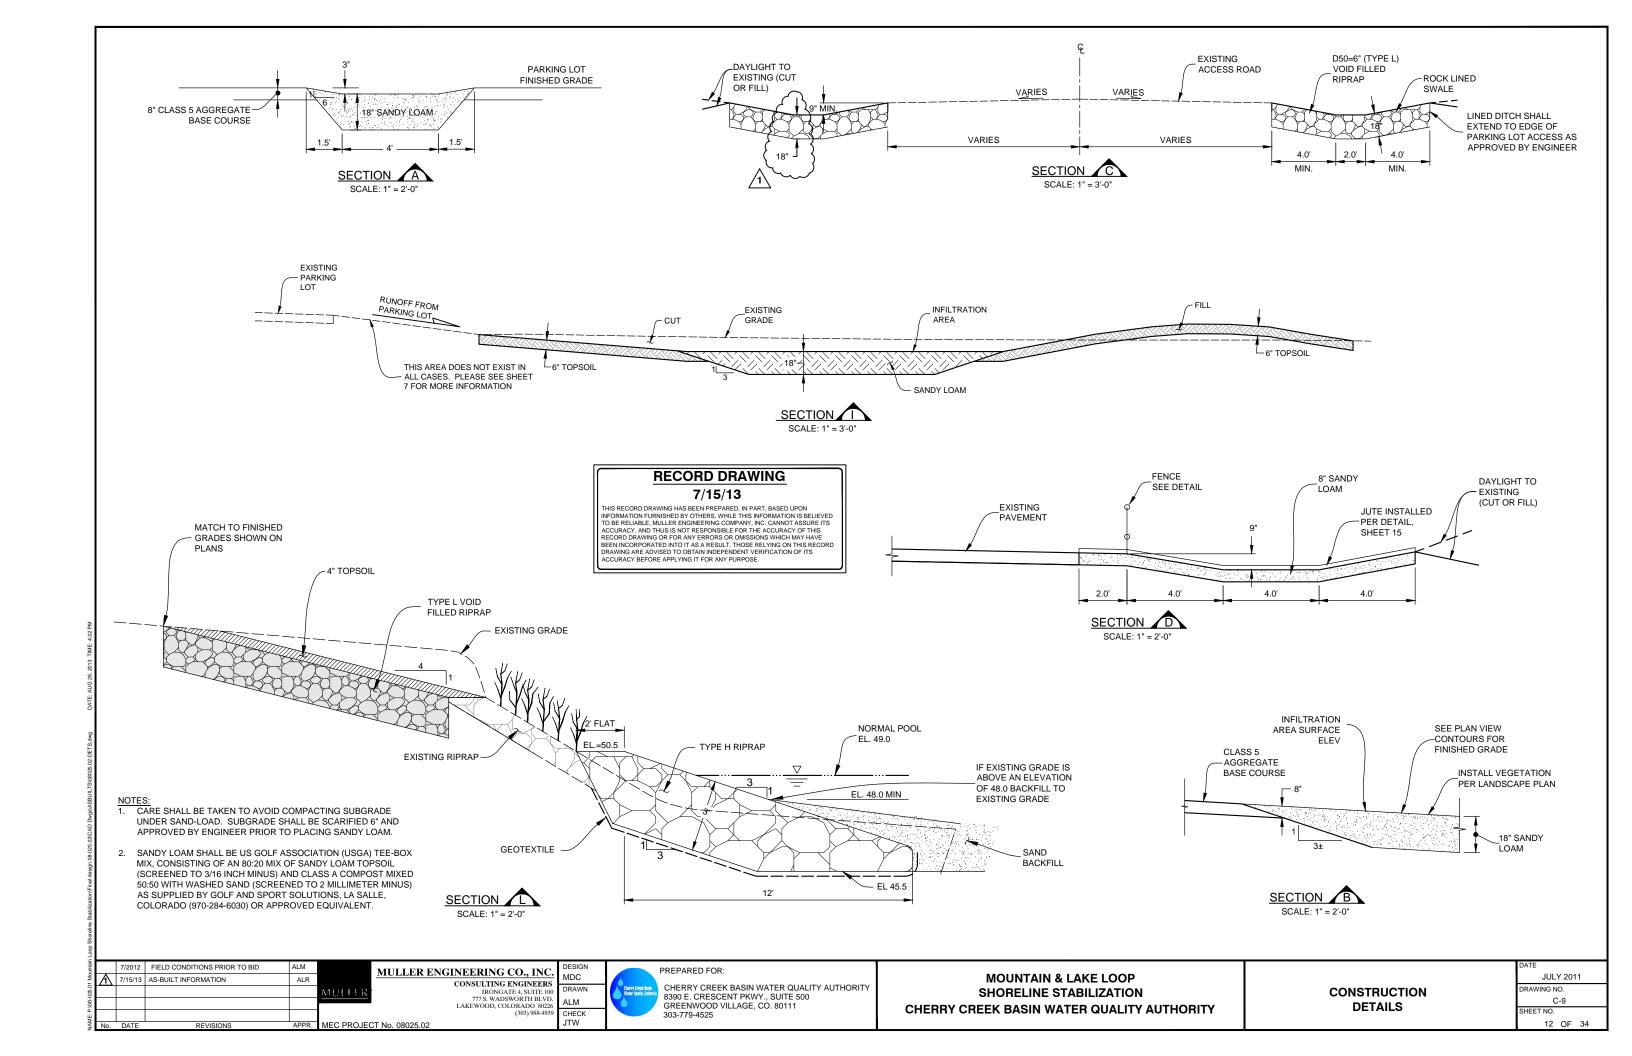

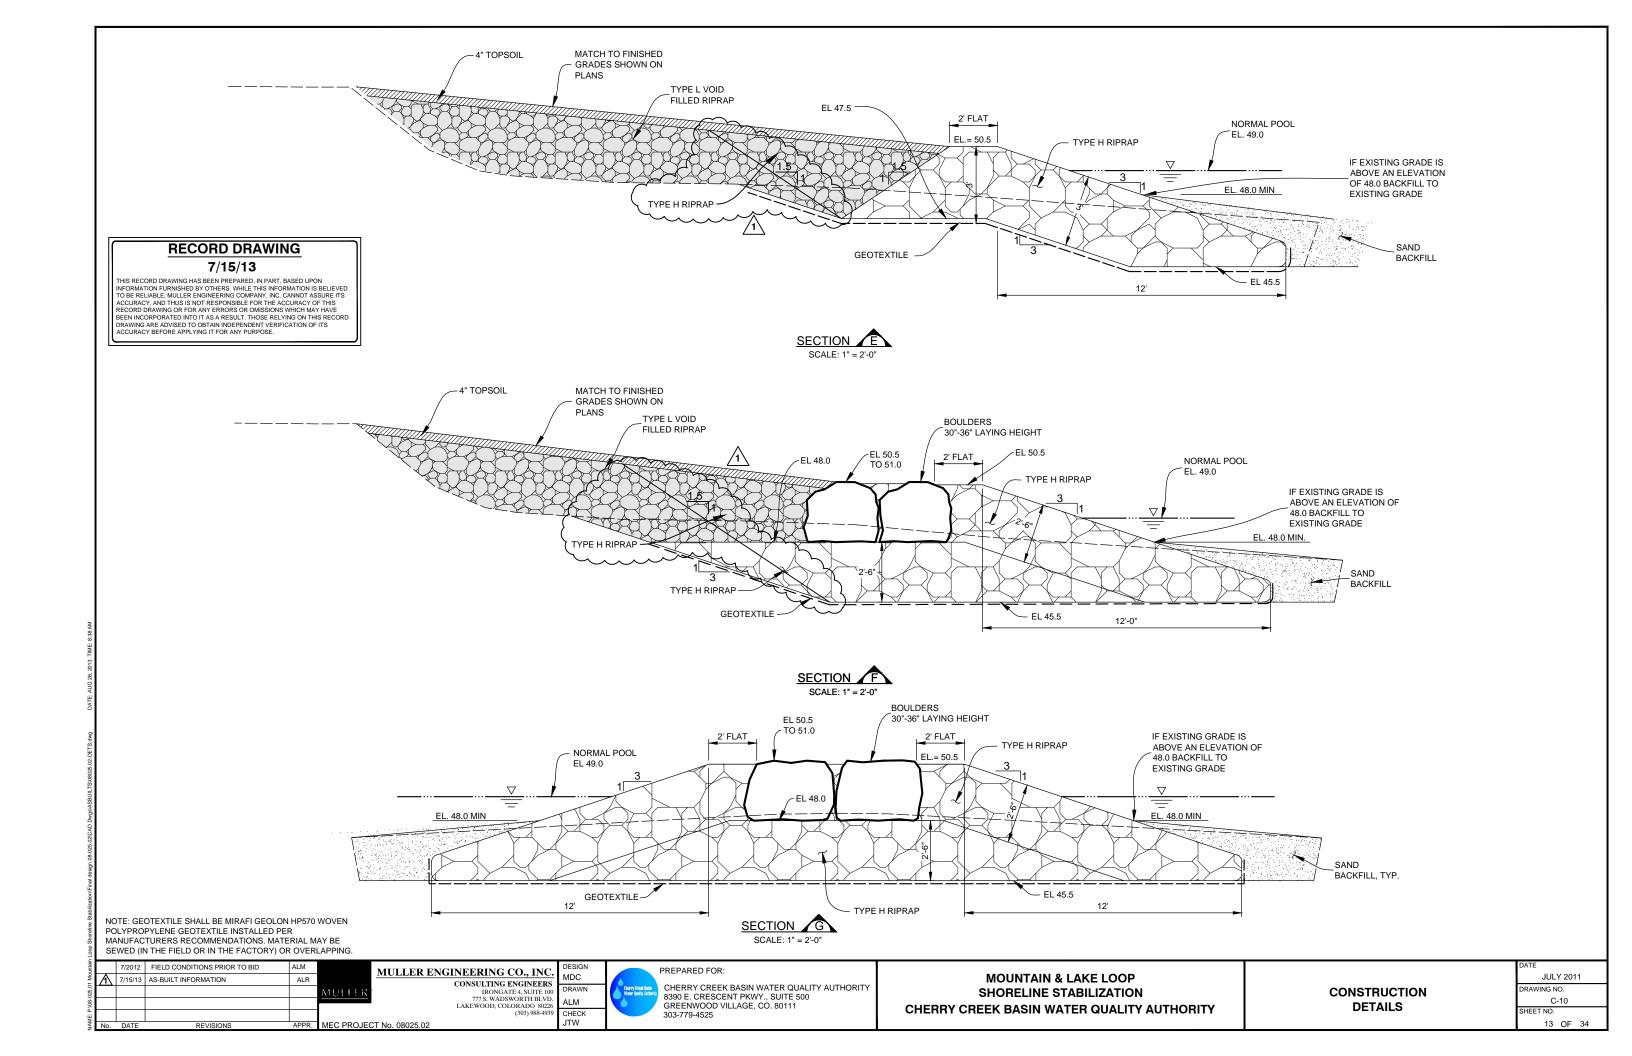

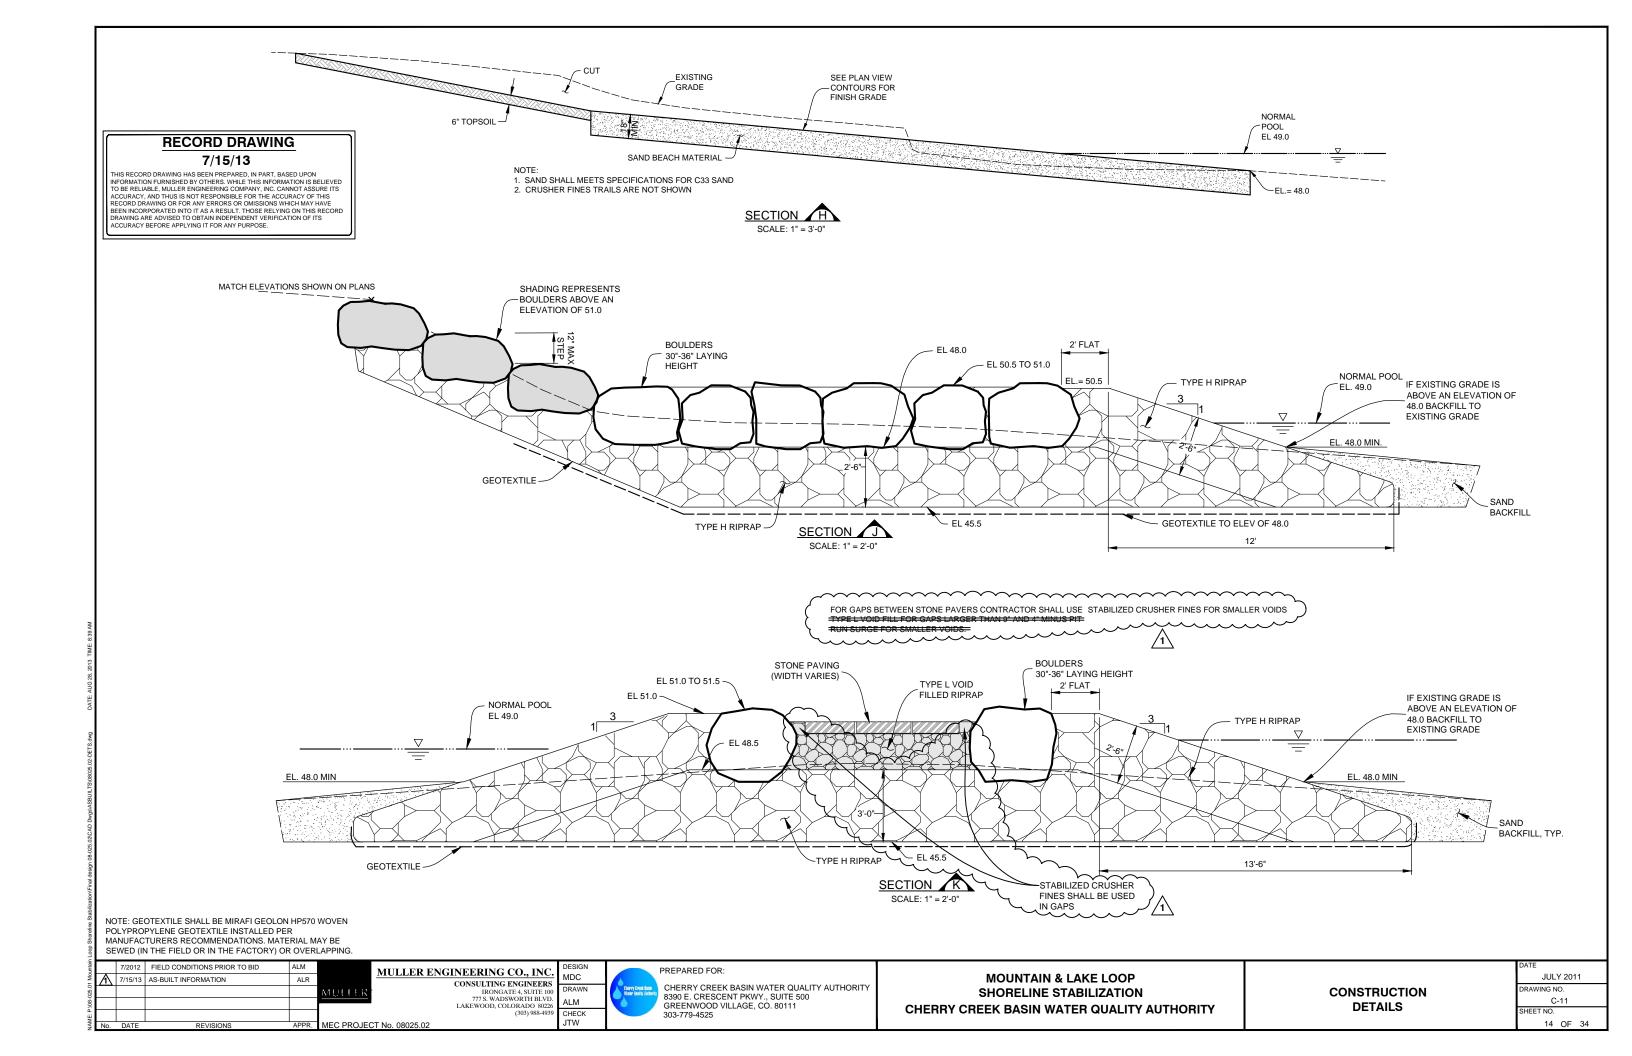

### RECORD DRAWING


### 7/15/13

THIS RECORD DRAWING HAS BEEN PREPARED, IN PART, BASED UPON INFORMATION FURNISHED BY OTHERS. WHILE THIS INFORMATION IS BELIEVED TO BE RELIABLE, MULLER ENGINEERING COMPANY, INC. CANNOT ASSURE ITS ACCURACY, AND THUS IS NOT RESPONSIBLE FOR THE ACCURACY OF THIS RECORD DRAWING OR FOR ANY ERRORS OR OMISSIONS WHICH MAY HAVE BEEN INCORPORATED INTO IT AS A RESULT. THOSE RELYING ON THIS RECORD DRAWING ARE ADVISED TO OBTAIN INDEPENDENT VERIFICATION OF ITS ACCURACY BEFORE APPLYING IT FOR ANY PURPOSE.

COIR MAT (13' TOTAL WIDTH, 11' EXPOSED ON STAKES PLACED AS SURFACE WITH 12" BURIED SHOWN, 3' OC LONGITUDINALLY PROPOSED CHANNEL INVERT -

**BLANKET LINED SWALE** 

SCALE: 1" = 3' - 0"

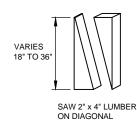


**WOOD STAKE DETAIL** 

N.T.S.

- NOTES:

  1. SEED AND MULCH PRIOR TO INSTALLING JUTE. JUTE TOTAL WIDTH

  WILL BE EXPOSED OF SHALL BE 13", BUT ONLY 10'-6" TO 11' OF WIDTH WILL BE EXPOSED ON SLOPE. STAKE JUTE BETWEEN ANCHORED ENDS WITH 3 ROWS OF 18" LONG WOOD STAKES @ 36" O.C. (SEE STAKING PATTERN 1 AND 3).
- POSITION ROW STAKES IN AN ALTERNATING STAGGER PATTERN SO THAT STAKES FOR THE ROW ARE POSITIONED IN BETWEEN STAKES FOR ADJACENT ROWS.
- 3. CONTRACTOR SHALL USE STEEL PENETRATION RODS OR OTHER MEANS AS NECESSARY TO PENETRATE RIPRAP LAYER WITH WOOD STAKES.
- 4. JUTE AT LAKE LOOP PARKING LOT AND AT DECOMMISSIONED TRAIL RESTORATION AREAS MAY BE INSTALLED PER STANDARD GESC DETAIL

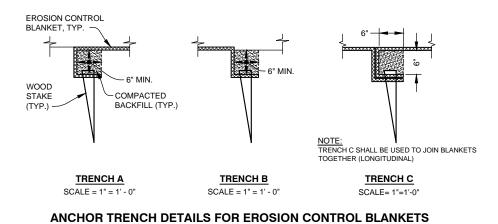

10'-6" TO 11'-0" 10'-6" TO 11'-0" VARIES \_\_ EQUAL EQUAL SPACING **EQUAL SPACING** TRENCH A 24" TYP TRENCH A TOE -TRENCH C PATTERN 2 PATTERN 1

INSTALL WOOD STAKES SUCH THAT ONLY 1" IS EXPOSED ABOVE GROUND. STAKING PATTERNS FOR EROSION CONTROL BLANKET

SCALE: 1" =5'

	7/2012	FIELD CONDITIONS PRIOR TO BID	ALM	MULLER E
A	7/15/13	AS-BUILT INFORMATION	ALR	WEERER E
				MULLER
No.	DATE	REVISIONS	APPR.	MEC PROJECT No. 08025.02

MULLER ENGINEERING CO., INC. CONSULTING ENGINEERS
IRONGATE 4, SUITE 100
777 S. WADSWORTH BLVD.
LAKEWOOD, COLORADO 80226
(303) 988-4939




PREPARED FOR: CHERRY CREEK BASIN WATER QUALITY AUTHORITY 8390 E. CRESCENT PKWY., SUITE 500 GREENWOOD VILLAGE, CO. 80111 303-779-4525

**MOUNTAIN & LAKE LOOP SHORELINE STABILIZATION CHERRY CREEK BASIN WATER QUALITY AUTHORITY** 

**CONSTRUCTION DETAILS** 

CIVIL

JULY 2011 C-12 15 OF 34

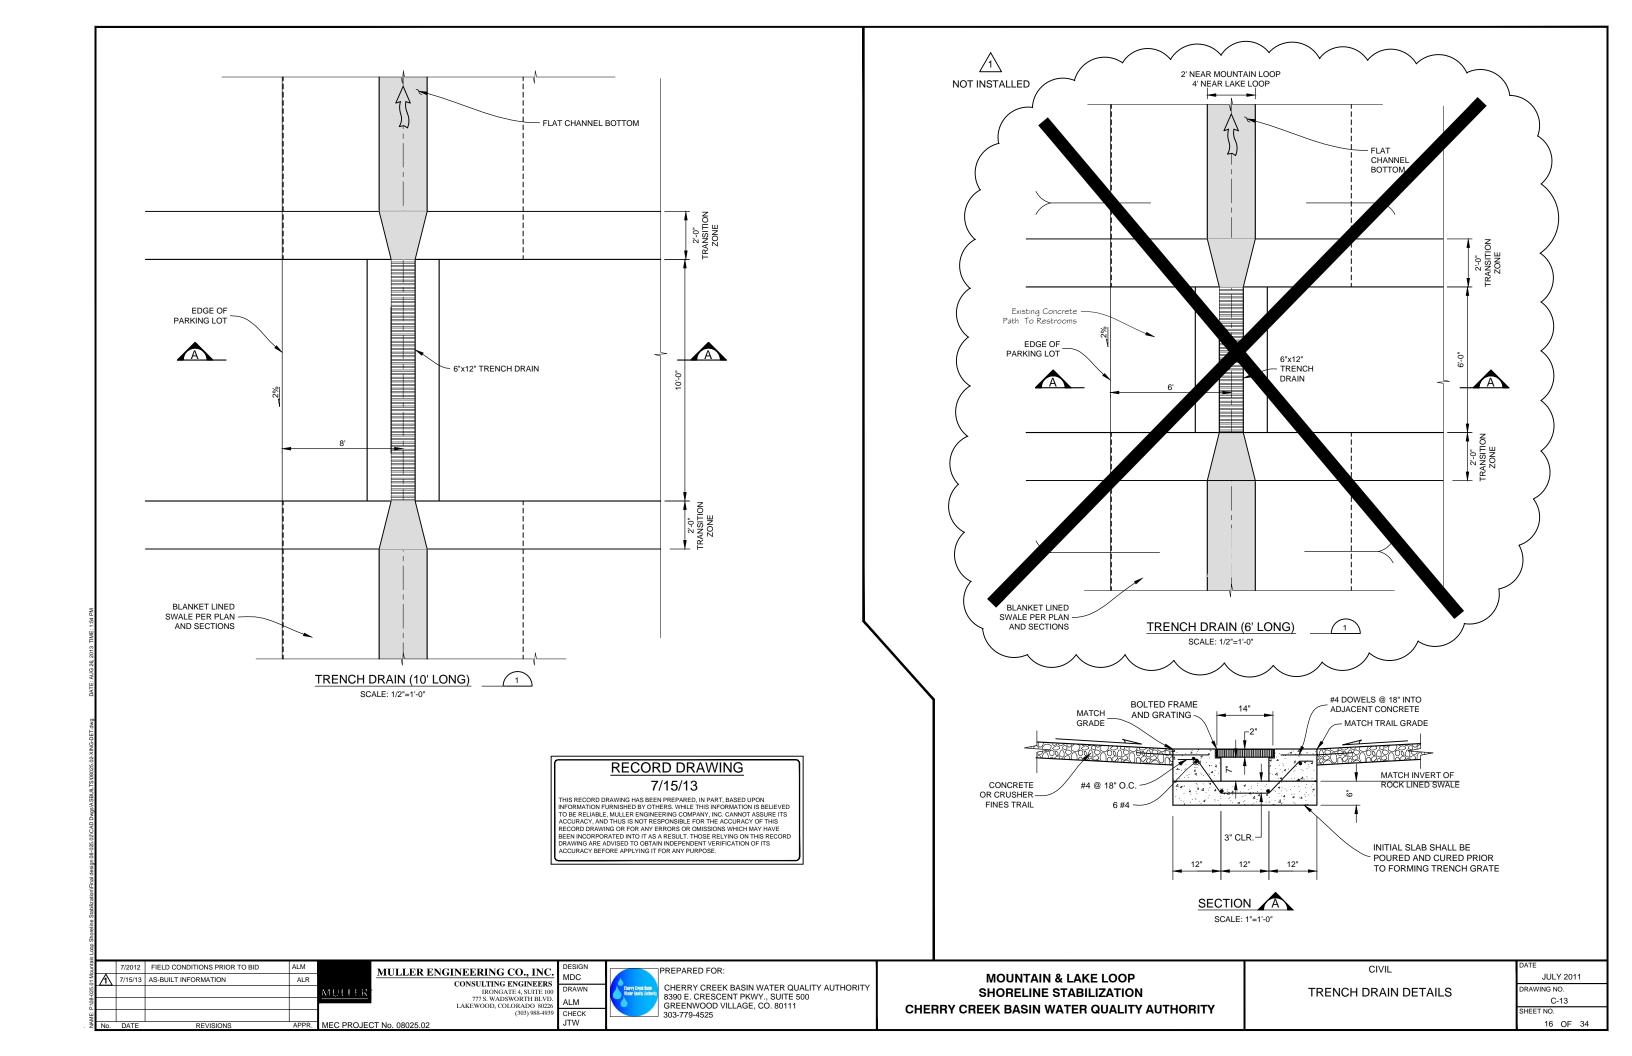

### **LAYOUT & MATERIALS NOTES**

- CONTRACTOR SHALL MAINTAIN AND PRESERVE EXISTING MONUMENTS, BENCHMARKS, AND CONTROL POINTS.
- LOCATIONS OF UTILITIES ARE GRAPHIC ONLY AND MAY NOT REPRESENT ACTUAL FIELD CONDITIONS. CONTRACTOR SHALL CALL UTILITY NOTIFICATION CENTER OF COLORADO 1-800-922-1987 TO LOCATE ALL UTILITIES PRIOR TO COMMENCING WORK. CONTRACTOR SHALL VERIFY LOCATIONS AND BURY DEPTHS OF ALL UTILITIES ON SITE. EXISTING UTILITIES SHALL BE PROTECTED FROM DAMAGE BY THE CONTRACTOR. DAMAGED UTILITIES SHALL BE REPAIRED AT THE CONTRACTOR'S EXPENSE. IT SHALL BE THE RESPONSIBILITY OF THE CONTRACTOR TO MAINTAIN AND PROVIDE FOR ADEQUATE DRAINAGE THROUGH THE SITE DURING THE PROCESS OF EXCAVATION, GRADING AND EMBANKMENT THE GRADE SHALL BE MAINTAINED IN SUCH CONDITION THAT IT IS WELL DRAINED AT ALL TIMES.
- 3. WORK AND MATERIALS SHALL CONFORM TO COLORADO STATE PARKS SERVICE STANDARDS, REGULATIONS, AND CODES FOR DESIGN AND CONSTRUCTION OF PUBLIC IMPROVEMENTS
- 4 PROPOSED FINISHED GRADES AND PAVEMENTS SHALL ABUT EXISTING CURBS, PAVEMENTS, ETC. IN BOTH LINE, AND SRADE. CONTRACTOR SHALL NOTIFY THE OWNER'S REPRESENTATIVE IMMEDIATELY OF ANY DISCREPANCIES.
- 5. CONTRACTOR SHALL NOT WILLFULLY PROCEED WITH CONSTRUCTION AS DESIGNED WHEN IT IS OBVIOUS THAT PREVIOUSLY UNKNOWN OBSTRUCTIONS AND/OR GRADE DIFFERENCES EXIST THAT MAY NOT HAVE BEEN KNOWN DURING DESIGN. SUCH CONDITIONS SHALL BE IMMEDIATELY BROUGHT TO THE ATTENTION OF THE OWNER'S REPRESENTATIVE FOR DECISION, THE CONTRACTOR SHALL ASSUME FULL RESPONSIBILITY FOR ALL NECESSARY REVISIONS AND REPAIRS DUE TO FAILURE TO GIVE SUCH NOTIFICATION AT NO ADDITIONAL COST TO OWNER.
- 6. CONTRACTOR SHALL PRESENT FOR AUTHORIZATION TO THE OWNER'S REPRESENTATIVE ANY PRUNING, PLANT REMOVAL, OR OTHER LANDSCAPE MAINTENANCE DEEMED NECESSARY FOR THE CONSTRUCTION OF PROPOSED IMPROVEMENTS PRIOR TO COMMENCING WITH WORK
- 7. CONTRACTOR SHALL OBTAIN ALL APPLICABLE CODES, LICENSES, PERMITS, BONDS, ETC. NECESSARY TO PERFORM THE PROPOSED WORK 72 HOURS PRIOR TO THE START OF ANY CONSTRUCTION
- CONTRACTOR SHALL SUBMIT A BICYCLE/PEDESTRIAN TRAFFIC DETOUR PLAN FOR APPROVAL PRIOR TO CONSTRUCTION. THE CONTRACTOR SHALL PROVIDE LIGHTS, SIGNS, BARRICADES, FLAG MEN, OR OTHER DEVICES NECESSARY TO PROVIDE FOR PUBLIC SAFETY, CUSTOMER ACCESS, AND SAFE TRAFFIC IN ACCORDANCE WITH THE MUTCD, CURRENT EDITION, BICYCLE/PEDESTRIAN THROUGH TRAFFIC SHALL BE MAINTAINED DURING THE DURATION OF
- 9. CONTRACTOR SHALL NOTIFY THE OWNER'S REPRESENTATIVE 72 HOURS PRIOR TO START OF ANY CONSTRUCTION. IF WORK IS SUSPENDED FOR ANY PERIOD OF TIME AFTER INITIAL START-UP. THE CONTRACTOR SHALL NOTIFY THE OWNER'S REPRESENTATIVE OF REASON FOR SUSPENSION AND ESTIMATED TIME OF SUSPENSION WITHIN 72 HOURS OF SUSPENSION. CONTRACTOR SHALL NOTIFY THE OWNER'S REPRESENTATIVE 72 HOURS PRIOR TO RESTART OF
- 10. CONTRACTOR SHALL BE RESPONSIBLE FOR REPLACING EXISTING PAVEMENT MARKINGS, SIGNING, LANDSCAPE, HARDSCAPE, OR OTHER ITEMS THAT HAVE BEEN DAMAGED DURING CONSTRUCTION AT CONTRACTOR'S EXPENSE CONTRACTOR SHALL PROTECT ALL ADJACENT IMPROVEMENTS (BUILDINGS, PARKING LOTS, LANDSCAPE AREAS, ETC.) FROM DAMAGE AND EROSION DUE TO CONSTRUCTION ACTIVITIES. ALL DISTURBED AREAS SHALL BE RESTORED TO A MINIMUM OF THEIR ORIGINAL CONDITION AT THE CONTRACTOR'S EXPENSE.
- 11. CONSTRUCTION SITES AND STAGING AREAS MUST BE FENCED AND MAINTAINED IN A SECURE CONDITION AT ALL TIMES. KEEP FENCING AND SURROUNDING AREAS CLEAR OF TRASH AND DEBRIS. ANY CONSTRUCTION DEBRIS OR MUD DROPPED INTO MANHOLES, PIPES, OR TRACKED ONTO EXISTING ROADWAYS SHALL BE REMOVED IMMEDIATELY BY CONTRACTOR. CONTRACTOR SHALL REPAIR ANY EXCAVATIONS OR PAVEMENT FAILURES CAUSED BY CONSTRUCTION WITHIN OR IN THE VICINITY OF THE LIMITS OF CONSTRUCTION. THE CONTRACTOR SHALL BE RESPONSIBLE FOR DAMAGE DUE TO CONSTRUCTION AT NO ADDITIONAL COSTS TO OWNER. THE CONTRACTOR SHALL REMOVE ALL SEDIMENT, MUD, AND CONSTRUCTION DEBRIS THAT MAY ACCUMULATE IN THE FLOW LINES, PRIVATE PROPERTY, AND PUBLIC RIGHTS OF WAYS AS A RESULT OF THIS CONSTRUCTION PROJECT. REMOVAL SHALL BE CONDUCTED WITHIN 48 HOURS, RETURN ALL CONSTRUCTION STAGING SITES TO THEIR ORIGINAL CONDITION UPON COMPLETION OF THE
- 12. CONTRACTOR SHALL BE SOLELY AND COMPLETELY RESPONSIBLE FOR THE CONDITIONS AT THE JOB SITE, INCLUDING SAFETY OF PERSONS AND PROPERTY DURING PERFORMANCE OF THE WORK
- 13. ALL QUANTITIES ARE BASED ON HORIZONTAL PLAN MEASUREMENTS. CONTRACTOR SHALL MAKE ALLOWANCES FOR

### TREE & LANDSCAPE PROTECTION NOTES

- CONSTRUCTION FENCING SHALL NOT BE CLOSER TO TREES THAN THEIR DRIPLINE (OUTER CANOPY).
- CONSTRUCTION PARKING SHALL NOT BE ALLOWED UNDER TREES.
- NOTIFY LANDSCAPE ARCHITECT OR ECOLOGIST AFTER SURVEY AND AT LEAST 48 HOURS PRIOR TO CONSTRUCTION TO INSPECT AREAS FOR IDENTIFICATION OF TREES TO BE PROTECTED.
- IF ACCESS CORRIDORS OR TRAIL CONSTRUCTION MUST APPROACH TREES, PROTECT TREE BARK BY TYING STRAW (NEVER HAY) BALES TO THE TRUNK (3 OR MORE BALES TO SURROUND LARGER TREES. PROTECT TREE ROOTS WHERE EQUIPMENT WILL CROSS UNDER TREES, WITH LANDSCAPE FABRIC UNDER 8-12" LAYER OF CHIPPED WOOD MULCH (FROM THINNED TREES). MULCHED TREES WILL REQUIRE 50 GALLONS OF WATER PER TREE; MORE IF ECOLOGIST, LANDSCAPE ARCHITECT, OR ENGINEER REQUESTS. SOAK TREES WITH WATER 2 TIMES PER MONTH OR AS REQUIRED TO KEEP HEALTHY DURING CONSTRUCTION.
- FOLLOWING CONSTRUCTION, REMOVE ALL CHIPPED MULCH AND FABRIC. RESEED WITH INDICATED MIXTURE (TABLE 1 OR 2 FOR NATIVE AREAS, TABLE 4 FOR LAWNS).
- FIELD FIT" TRAILS TO EXISTING LANDSCAPE TO AVOID IMPACTS TO HEALTHY, NATIVE TREES, ALLOWING TRAIL TO BE 5'-10' FROM TREE TRUNK.
- TREES IDENTIFIED FOR PROTECTION SHALL BE PROTECTED WITH BOARDS, FENCING, & PROTECTIVE STRAW BALES ACCORDING TO TREE PROTECTION DETAIL, NOTES, & SPECS.

### **RUSSIAN OLIVE REMOVAL NOTES**

- SAW OR PRUNE RUSSIAN OLIVE TRUNK FLUSH WITH SOIL SURFACE AND IMMEDIATELY PAINT THE FRESH CUT STUMP WITH ROUNDUP ULTRA CONCENTRATE, UNDILUTED. CARE SHOULD BE TAKEN TO THOROUGHLY PAINT THE LIVING CAMBIUM AREA (BETWEEN THE REDDISH BROWN BARK AND THE WOOD OF THE TREES). PRUNE AND RETREAT ANY
- REMOVE ANY AND ALL RUSSIAN OLIVES, AS DESIGNATED BY ECOLOGIST, WITHIN A 15 FOOT SWATH OUTSIDE OF THE LIMITS OF WORK

### **PLANTING & RESTORATION NOTES**

- THE CONTRACTOR SHALL SUPPLY ALL PLANTS IN QUANTITIES SUFFICIENT TO COMPLETE THE WORK SHOWN ON THE PLAN. SHOULD ANY DISCREPANCIES EXIST BETWEEN QUANTITIES SHOWN IN THE PLANT LIST AND THOSE SHOWN IN THE DRAWINGS, THE DRAWINGS SHALL TAKE PRECEDENCE
- ALL PLANT MATERIAL SHALL BE REVIEWED BY THE OWNER'S REPRESENTATIVE PRIOR TO INSTALLATION. CONTRACTOR SHALL INSURE PLANT MATERIAL MEETS THE SPECIFICATIONS OF THE AMERICAN STANDARDS FOR NURSERY STOCK (LATEST EDITION) AS SET FORTH BY THE AMERICAN ASSOCIATION OF NURSERYMEN.
- CONTRACTOR SHALL FURNISH PLANT MATERIALS FREE OF PESTS OR PLANT DISEASES. PRESELECTED OR "TAGGED" MATERIAL MUST BE INSPECTED BY THE CONTRACTOR AND CERTIFIED PEST AND DISEASE FREE. IT IS THE CONTRACTOR'S OBLIGATION TO WARRANTY ALL PLANT MATERIALS PER THE SPECIFICATIONS. ECOLOGIST SHALL BE NOTIFIED WHICH NURSERY WILL SUPPLY PLANTS AT LEAST TWO WEEKS PRIOR TO ORDER TO INSPECT AND APPROVE PLANTS AND SPECIES.
- CONTRACTOR SHALL STAKE PLANT LOCATIONS FOR THE REVIEW BY THE OWNER'S REPRESENTATIVE. PRIOR TO DIGGING PLANTING PITS. THE CONTRACTOR SHALL RELOCATE ANY PLANT AS DIRECTED BY THE OWNER'S REPRESENTATIVE PRIOR TO PLANTING AT NO ADDITIONAL COST TO THE OWNER.ECOLOGIST OR ANDSCAPE ARCHITECT SHALL BE NOTIFIED 48 HOURS BEFORE DEEP PLANTING IN ORDER TO BE PRESENT. DURING COTTONWOOD INSTALLATION
- ANY LANDSCAPE AREAS OUTSIDE OF THE PROJECT LIMITS DISTURBED BY CONSTRUCTION OPERATIONS NOT DIRECTED BY OWNER'S REPRESENTATIVE, SHALL BE REPAIRED OR REPLACED AT THE CONTRACTOR'S
- CONTAMINATION OF PLANTING MIX/TOPSOIL DURING CONSTRUCTION WILL REQUIRE COMPLETE REPLACEMENT AT CONTRACTOR'S EXPENSE.
- CONTRACTOR SHALL EVALUATE EXISTING PLANT MATERIAL DESIGNATED FOR REMOVAL WITH OWNER'S REPRESENTATIVE, FOLLOWING REVIEW, THE CONTRACTOR SHALL TRANSPLANT ANY PLANT MATERIAL IDENTIFIED AS WORTHY. IF TRANSPLANT CANNOT BE ACCOMPLISHED IN A TIMELY FASHION, CONTRACTOR SHALL APPROPRIATELY STORE THE PLANT MATERIAL AND TRANSPLANT AT A TIME TO BE DETERMINED BY THE OWNER'S REPRESENTATIVE. CONTRACTOR SHALL PROVIDE THESE SERVICES AT NO ADDITIONAL COST

ALL CONSTRUCTION TRAFFIC AREAS, STAGING AREAS, OR ANY OTHER DISTURBED AREAS SHALL BE

- DISC AND CROSS DRILL OR BROADCAST AND HARROW MIX AS INDICATED ON PLANS.
- BROADCAST 800 POUNDS PER ACRE BIOSOL SOIL AMENDMENT ON SEEDING AREAS
- IMMEDIATELY FOLLOWING SEEDING, HYDROMULCH WITH 2500 POUNDS PER ACRE VIRGIN WOOD FIBER HYDROMULCH AND 150 POUNDS PER ACRE ORGANIC (PSILLIUM SEED) TACKIFIER.
- SEEDING AND PLANTING OPERATIONS SHALL BE COMPLETED SEPTEMBER 15 TO APRIL 15TH, LATER PLANTING DATES MAY REQUIRE ADDITIONAL ESTABLISHMENT WATERING. TEMPORARY IRRIGATION SYSTEM TO BE BID AS BID ALTERNATE 4 "TEMPORARY IRRIGATION" REFER TO "TEMPORARY IRRIGATION SCHEDULE" TEMPORARY IRRIGATION TO BE OVERHEAD SPRINKLER & WATER TRUCKS, OR APPROVED EQUIVALENT.
- OVERLAP ADJACENT SEED MIXTURES 24" MINIMUM
- SOME AREAS ARE TO BE OVER-SEEDED WITH TWO MIXES, SEE PLAN.

CONSTRUCTION AND WARRANTY PERIOD WEED CONTROL SHOULD BE CONDUCTED TO CONTROL AL ANNUAL, BIENNIAL AND PERENNIAL NOXIOUS WEEDS TO PREVENT SEED PRODUCTION AND SPREAD TO THE CONSTRUCTION AREAS. AREAS OF WEEDS WITHIN THE CONSTRUCTION ZONE OR WITHIN 1/4 MILE OF MOUNTAIN OR LAKE LOOPS ARE IN THE CRITICAL WEED CONTROL AREA. THIS WILL INCLUDE SPOT MOWING AND HERBICIDE APPLICATION, BY CERTIFIED WEED CONTROL SPECIALISTS, FOR WEEDS INCLUDING BUT NOT LIMITED TO: KOCHIA, CHEATGRASS, SALSOLA, TUMBLE MUSTARD, CURLY DOCK, SWEET CLOVER, DIFFUSE KNAPWEED, TEASEL, ALL EXOTIC THISTLE SPECIES, AND LEAFY SPURGE, TREATMENT OF WEED SPECIES WILL VARY IN SUITABLE CHEMICALS, METHODS AND TIMING, SEE PLANS & SPECS.

ECOLOGIST MUST BE CONTACTED AT CONSTRUCTION STARTUP TO WALK SITE WITH WEED CONTROL PERSONNEL TO IDENTIFY TREATMENT AREAS AND PROPOSED TREATMENTS

- INFILTRATION AREAS SHALL CONSIST OF AN 18 INCH LAYER OF SANDY LOAM.
- MIX VERY THOROUGHLY BEFORE INSTALLATION. INSPECTION AND APPROVAL OF THESE AREAS BY ECOLOGIST OR ENGINEER MUST BE OBTAINED PRIOR TO PLANTING. ADDITIONAL MIXING MAY BE REQUIRED.

- DECOMMISSIONED TRAIL AREAS:

  1. RIP COMPACTED TRAILS TO 6" DEPTH
- IF TRAIL AREA IS ERODED, APPLY SALVAGED TOPSOIL (APPROVED NON-WEED, DIRECT HAUL, IF POSSIBLE) TO SLIGHTLY OVERFILL TRAIL. RE-COMPACT SLIGHTLY TO FIRM SEED BED.
- CREATE WATER BARS, AS NECESSARY, TO DRAIN AWAY FROM RESTORED TRAIL, AS INDICATED BY ENGINEER, LANDSCAPE ARCHITECT, OR ECOLOGIST
- BROADCAST TABLE 1 NATIVE MIDGRASS PRAIRIE SEED MIXTURE AND RAKE TO COVER. APPLY BIOSOL AND HYDROMULCH WITH TACKIFIER. JUTE NETTING SHALL BE APPLIED ON SLOPES OVER 3:1 OR WHERE EROSION MAY OCCUR. ON SLOPES >5:1 INSTALL CHECK SLOTS 10' O.C.

HYRDROMULCH/EROSION CONTROL BLANKET:

1. EROSION CONTROL BLANKET WILL BE APPLIED PRIOR TO HYDROMULCH AND TACKIFIER ON ANY AREAS WHICH MAY REQUIRE ADDITIONAL EROSION PROTECTION, INCLUDING: SLOPES OVER 4:1, NEW TRAIL EDGES, BEACH EDGES, & TRAIL RESTORATION AREAS, PIN JUTE FABRIC 2 FEET ON CENTER ALONG EDGES AND THROUGHOUT BODY OF FABRIC WITH STEEL LANDSCAPE STAPLES TO SECURE. ON SLOPES OVER 3:1.

HYDROMULCH: 2500 MECHANICALLY DEFIBRATED VIRGIN WOOD FIBER HYDROMULCH SHALL BE APPLIED AT NO LESS THAN 2500#/ACRE RATE WITH150 #/ACRE ORGANIC (PSILLIUM SEED.) TACKIFIER, HYDROMULCH SHALL NOT BE INSTALLED DURING PRECIPITATION, WHEN THERE IS SNOW OR PUDDLING ON SITE.

### PLANTING SCHEDULE

### **DECIDUOUS TREES**

QTY.	ABV	BOTANICAL NAME	COMMON NAME	SIZE	COMMENTS
15	PS	POPULOUS SARGENTII	PLAINS COTTONWOOD	2" Cal.	B&B

### ALTERNATE ADD 3

POPULOUS SARGENTII PLAINS COTTONWOOD 2" Cal B&B

### SEED MIXES

TOPATION CROLID INC

COMMON NAME	SCIENTIFIC NAME	VARIETY	POUND/ACRE
NATIVE MIDGRASS PRAIRIE SEED MIXTURE			
Sideoats grama	Bouteloua curtipendula	Butte	5.00
Blue grama	Chondrosum gracile	Lovington	5.00
Switchgrass	Panicum virgatum	Blackwell	2.00
Indian ricegrass	Oryzopsis hymenoides	RImrock	1.00
Western wheatgrass	Pascopyrum smithii	Arriba	7.00
Alkali sacaton	Sporobolus aeroides	Native	2.00
Sand dropseed	Sporobolus cryptandrus	Native	2.00
Green needlegrass	Stipa viridula	Native	5.00
Fringed sage	Artemisia frigida	Native	0.05
Aster	Aster laevis	Native	0.05
Purple prairie dover	Dalea purpurea	Native	0.50
Blanket flower	Gaillardia aristata	Native	0.05
Tansy aster	Machaeranthera tanacetafolia	Native	0.05
Large-flowered penstemon	Penstemon grandiflorus	Native	0.05
Wand penstemon	Penstemon virgatus	Native	0.05
Prairie coneflower	Ratibida columnifera	Native	0.10
Showy goldeneye	Vigiuera multiflora	Native	0.10
Total PLS/acre			30.00

DRAINAGE OVER-SEED MIXTURE	SCIENTIFIC NAME	VARIETY	PLS#/AC
COMMON NAME			
Buffalograss	Buchloe dactyloides	Topgun	2
Nebraska sedge	Carex nebrascensis	Native	0.25
Baltic rush	Juncus balticus	Native	0.25
Inland saltgrass	Disticlis stricta	Native	0.5
Alkall sacaton	Sporobolus airoides	Native	2
Western Wheatgrass	Pascopyrum smithii	Arriba	1
			6

LEGEND: X COTTONWOOD

SCIENTIFIC NAME

Bouteloue Gracilis

Buchloe dactyloides

Elymus Trechycaulus

Distichilis stricta

W WILLOWS (@ 2' O.C.)

DOGWOODS (@ 3' O.C.) SUMACS (@ 4' O.C.)

LS/AC (PLS)

2.5

17.5

20

5

5

50

DRAWING

RECORD

IN PART, THIS INFOI ANY, INC. OR THE AC

### TABLE 2 ND TURF GRASS MIXTURE FOR PLS/AC SCIENTIFIC NAME Blue Grama, Lovingto 6.29 Sideoats Gama, Hachita 1.5 9.43 Switchgrass Trailblaze Yellow Indiangrass, Holt 1.2 7.55 eria Mac 12.58 Big Blues Andropogon Gerardi Elymus Canadensi

		^ ^ /		<del></del>
TABLE 4				TABLE 2
NATIVE SHORTGRASS SEED MIXTURE				UPLAND TURF GRASS MIXTURE FOR MOWED LAWN AREAS
COMMON NAME	SCIENTIFIC NAME	VARIETY	PLS LBS/ACRE	COMMON NAME
Buffalograss	Buchloe dactyloides	Sharp's	7.00	Western Wheatgrass, Arriba
Sideoats grama	Bouteloua curtipendula	Butte	6.00	Blue Grama, Lovington
Blue grama	Chondrosum gracile	Hachita	7.00	Buffalograss, Topgun
Inland saltgrass	Distichlis stricta	Native	2.00	\[ \]
Western wheatgrass	Pascopyrum smithii	Arriba	5.00	Junegrass Inland saltgrass
Sand dropseed	Sporobolus cryptandrus	Native	2.50	TOTAL
Fringed sage	Artemisia frigida	Native	0.10	TOTAL
Purple prairieclover	Dalea purpurea	Native	0.10	(
Blanket flower	Gailardia aristata	Native	0.10	7
Prairie coneflower	Ratibida columnifera	Native	0.10	]>
Sidebells penstemon	Penstemon secundiflorus	Native	0.10	]\

30.00

15.9

### TEMPORARY IRRIGATION TABLE

		tallation: late March to April 15th time frame:
Weeks	<u>Program</u>	Inches/Week
1-4	irrigate 3X/week 30 minutes per location	1"/week
5-8	irrigate 2X/week 45 minutes per location	1"/week
9-12	irrigate 1X/week 1 hour per location	2/3"/week
If funding allows:		
Until Sept 1	Irrigate 2X a month 1 hour per location	1/3"/week (ave.)
Schedule B Add A	lternate : One (1) extra year of irrigation, M	arch through Sept. as described above

Recommended irrigation for SEEDED NATIVE AREAS, assuming installation; late March to April 15th time frame

Program	Inches/Week
irrigate 2X/week 30 minutes per location	2/3"/week
irrigate 1X/week 1 hour per location	2/3"/week
irrigate 2X/month 1 hour per location	1/3"/week (ave.)
	Program irrigate 2X/week 30 minutes per location irrigate 1X/week 1 hour per location

7/2012 | FIELD CONDITIONS PRIOR TO BID DESIGN PREPARED FOR: MULLER ENGINEERING CO., INC 7/15/13 AS-BUILT INFORMATION ALR MOUNTAIN & LAKE LOOP CONSULTING ENGINEERS CHERRY CREEK BASIN WATER QUALITY AUTHORITY MULEEF 8390 E. CRESCENT PKWY., SUITE 500 LAKEWOOD, COLORADO 802 GREENWOOD VILLAGE, CO. 80111


LANDSCAPE PLANS **NOTES. LEGENDS. & PLANTING SCHEDULE** 


RAWING NO L-0 17 OF 34


# APPR. MEC PROJECT No. 08025.02


CHECK


SHORELINE STABILIZATION CHERRY CREEK BASIN WATER QUALITY AUTHORITY

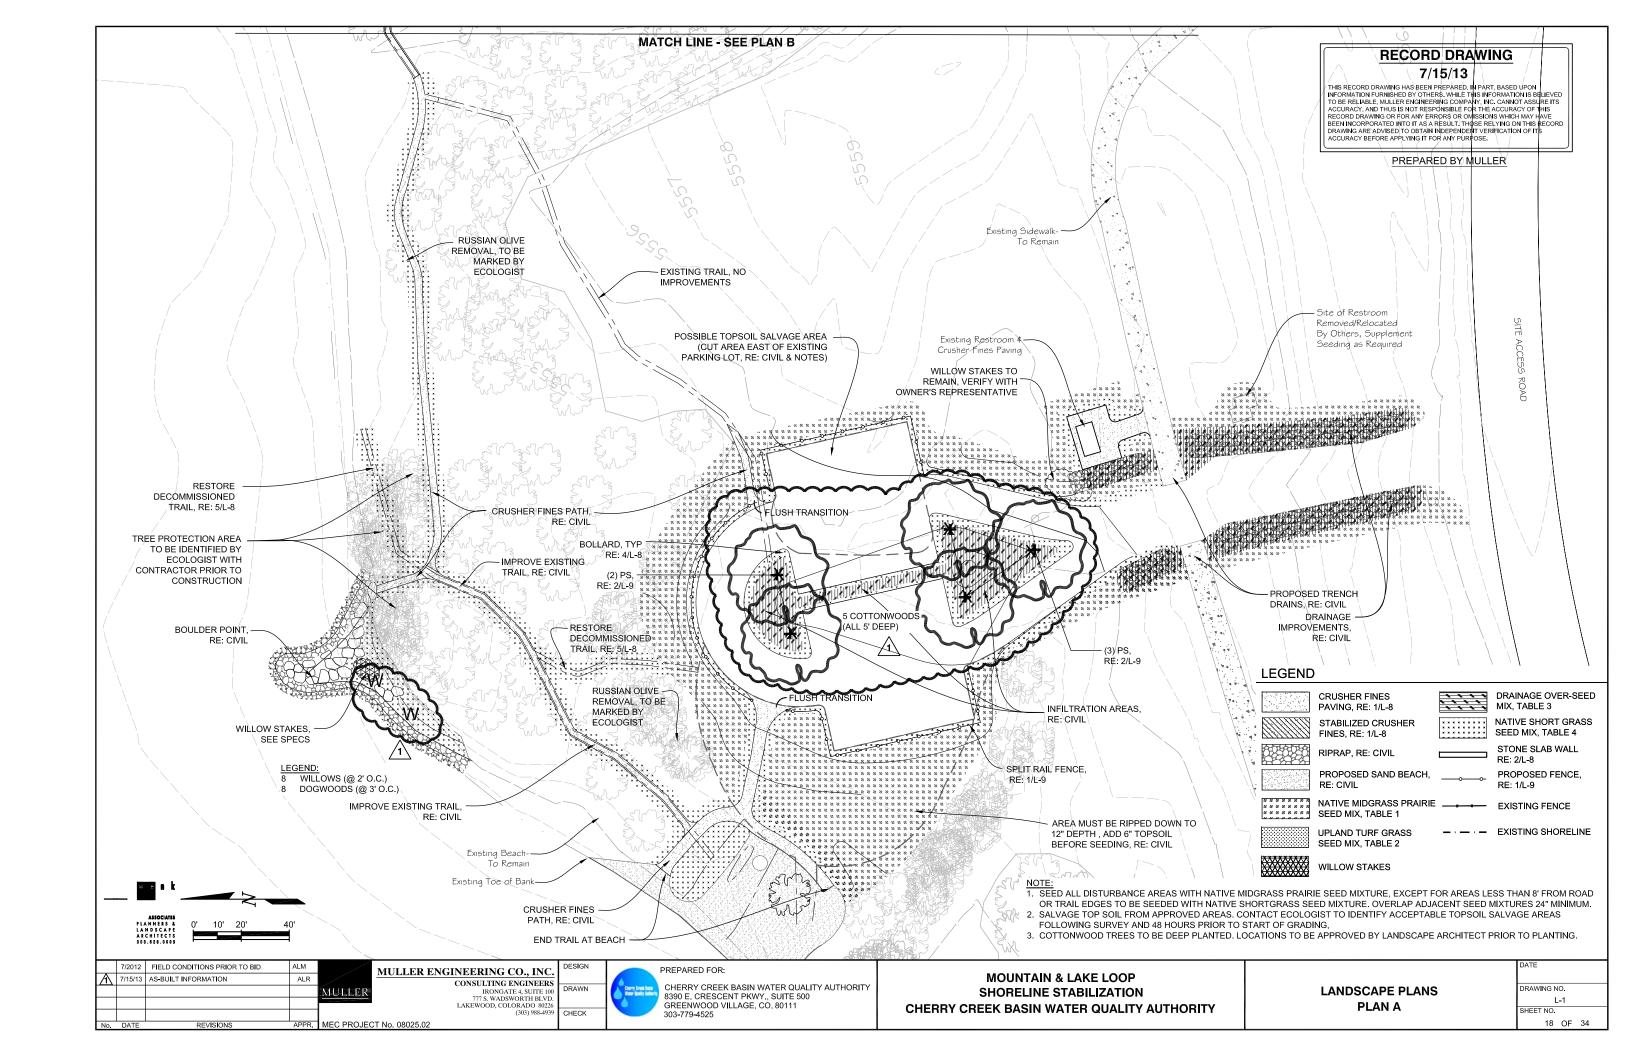


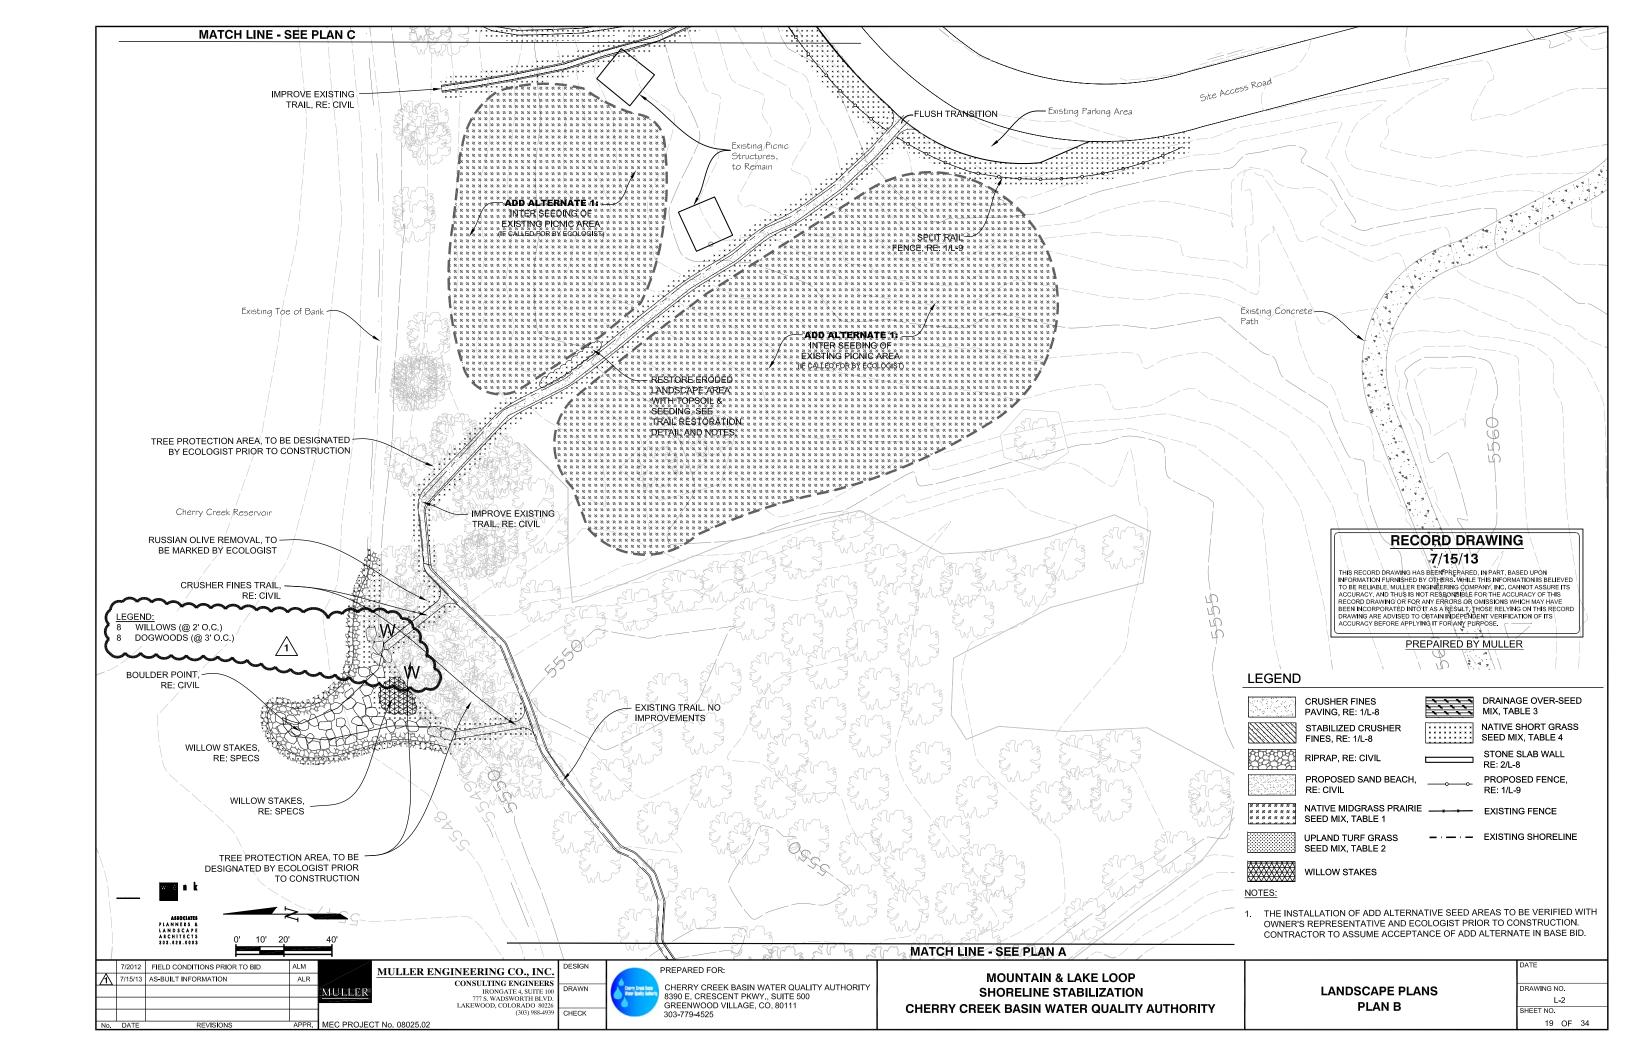


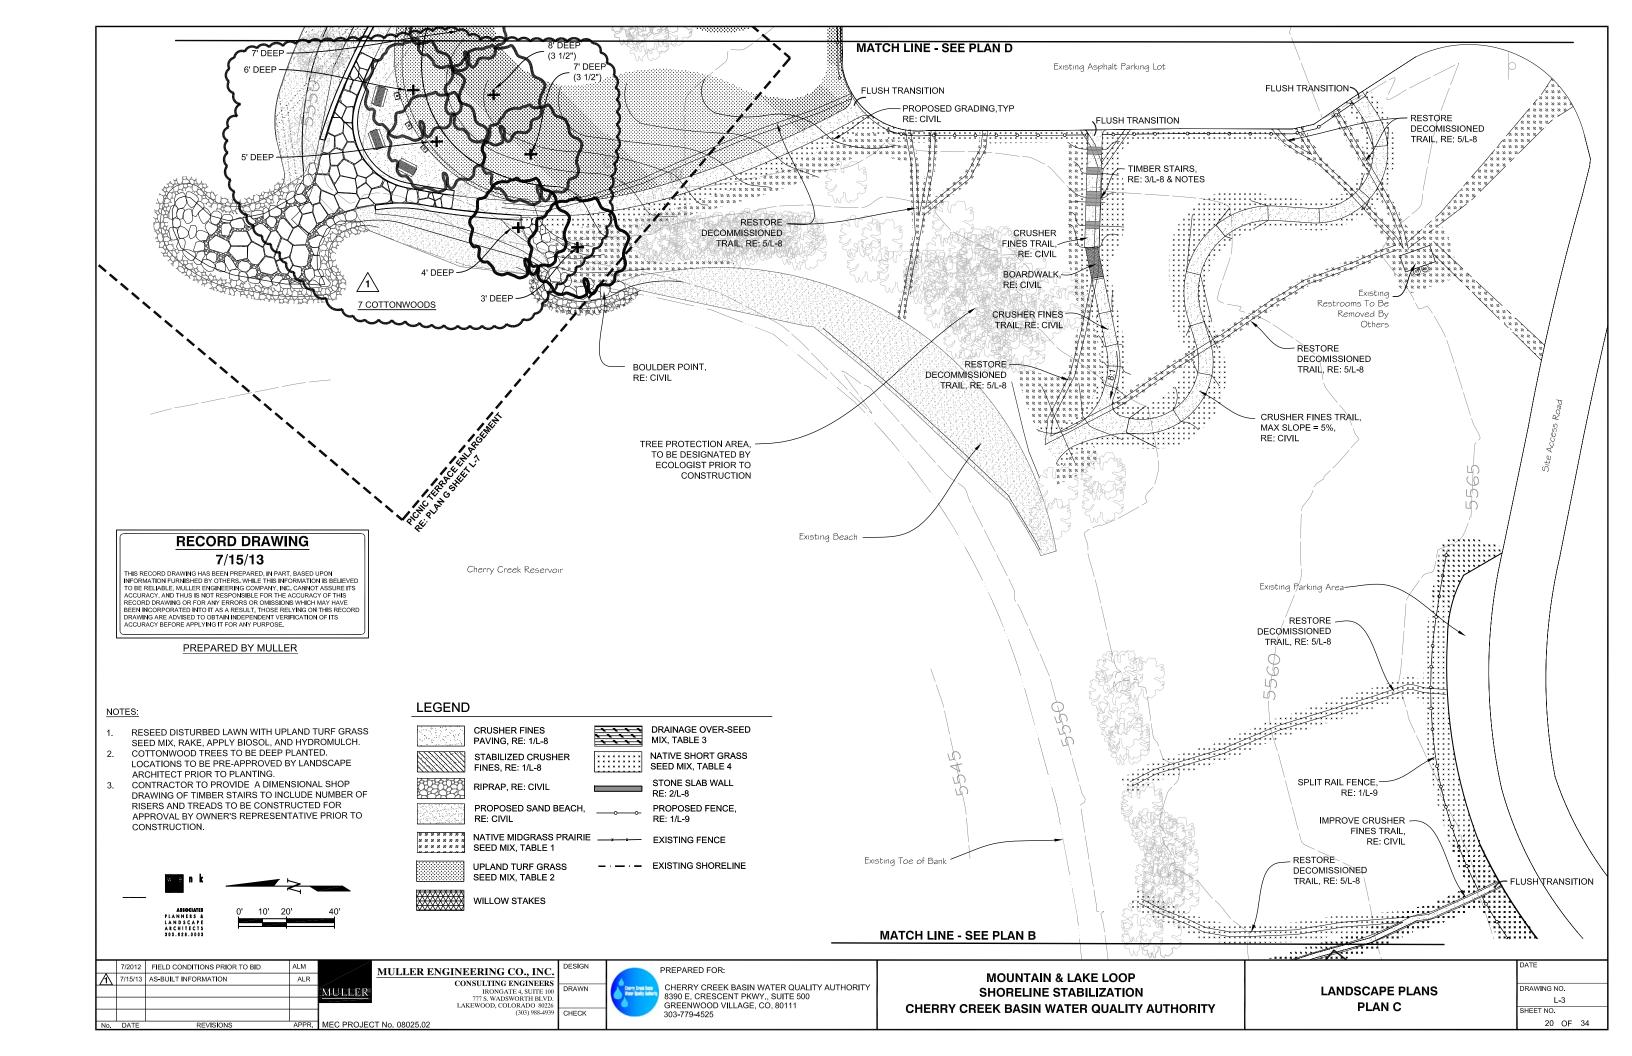

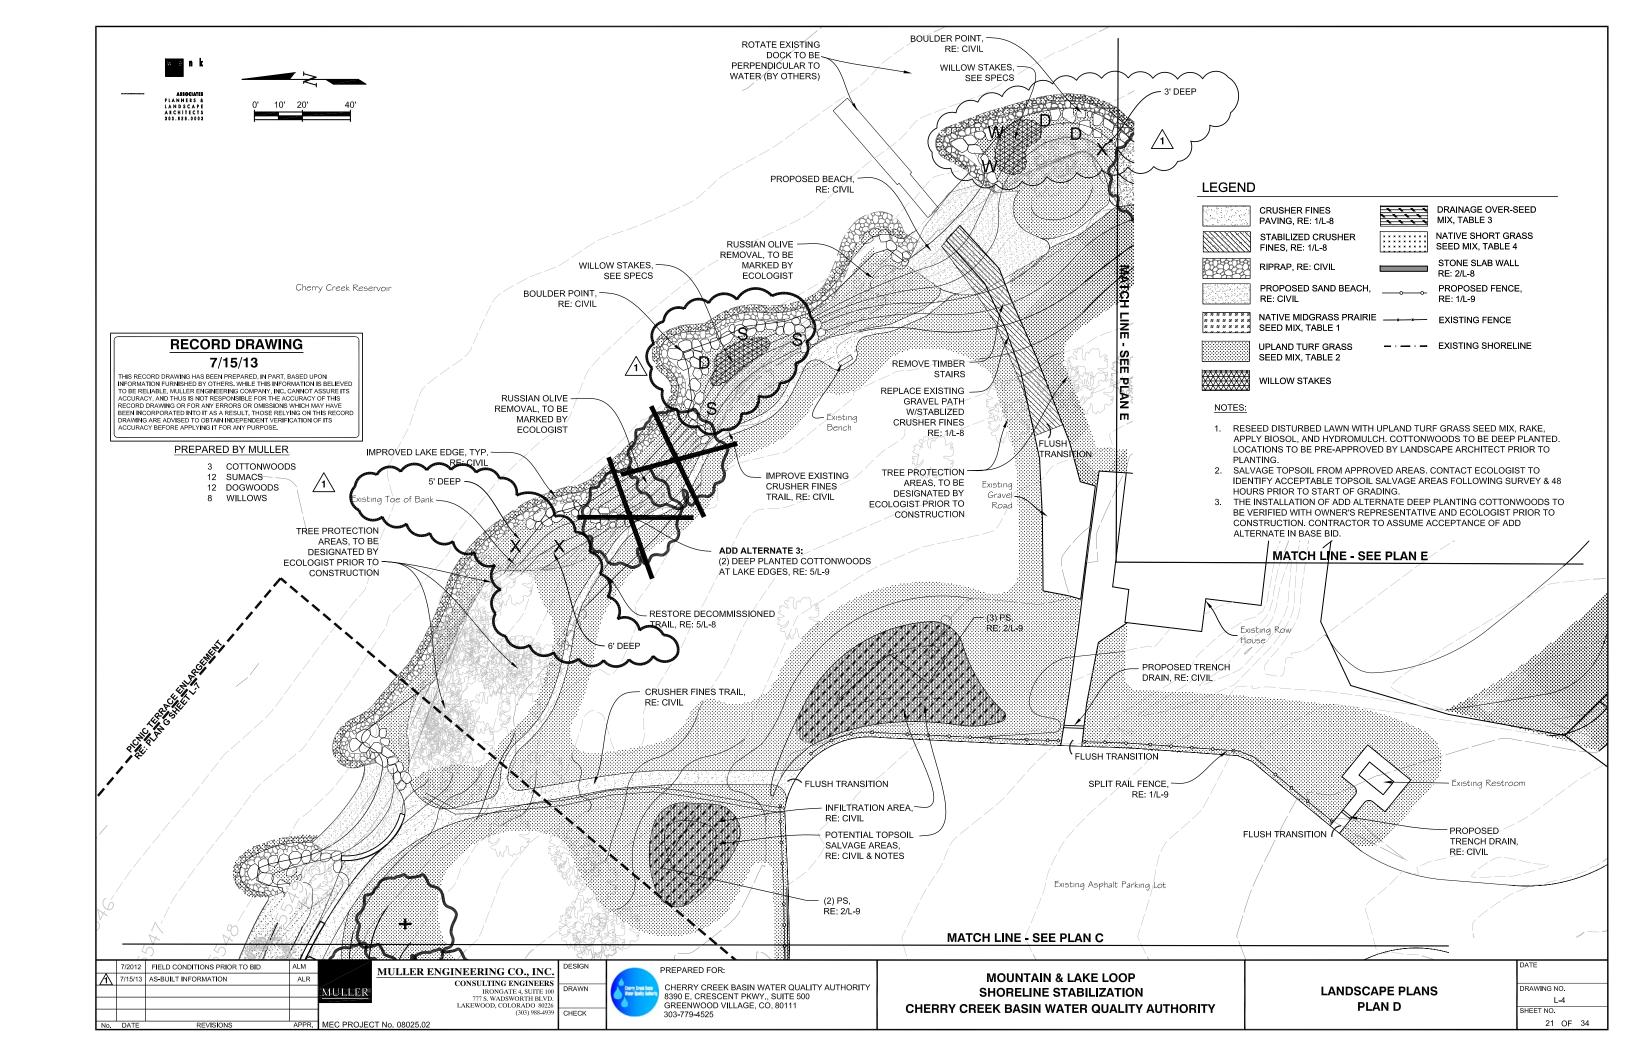

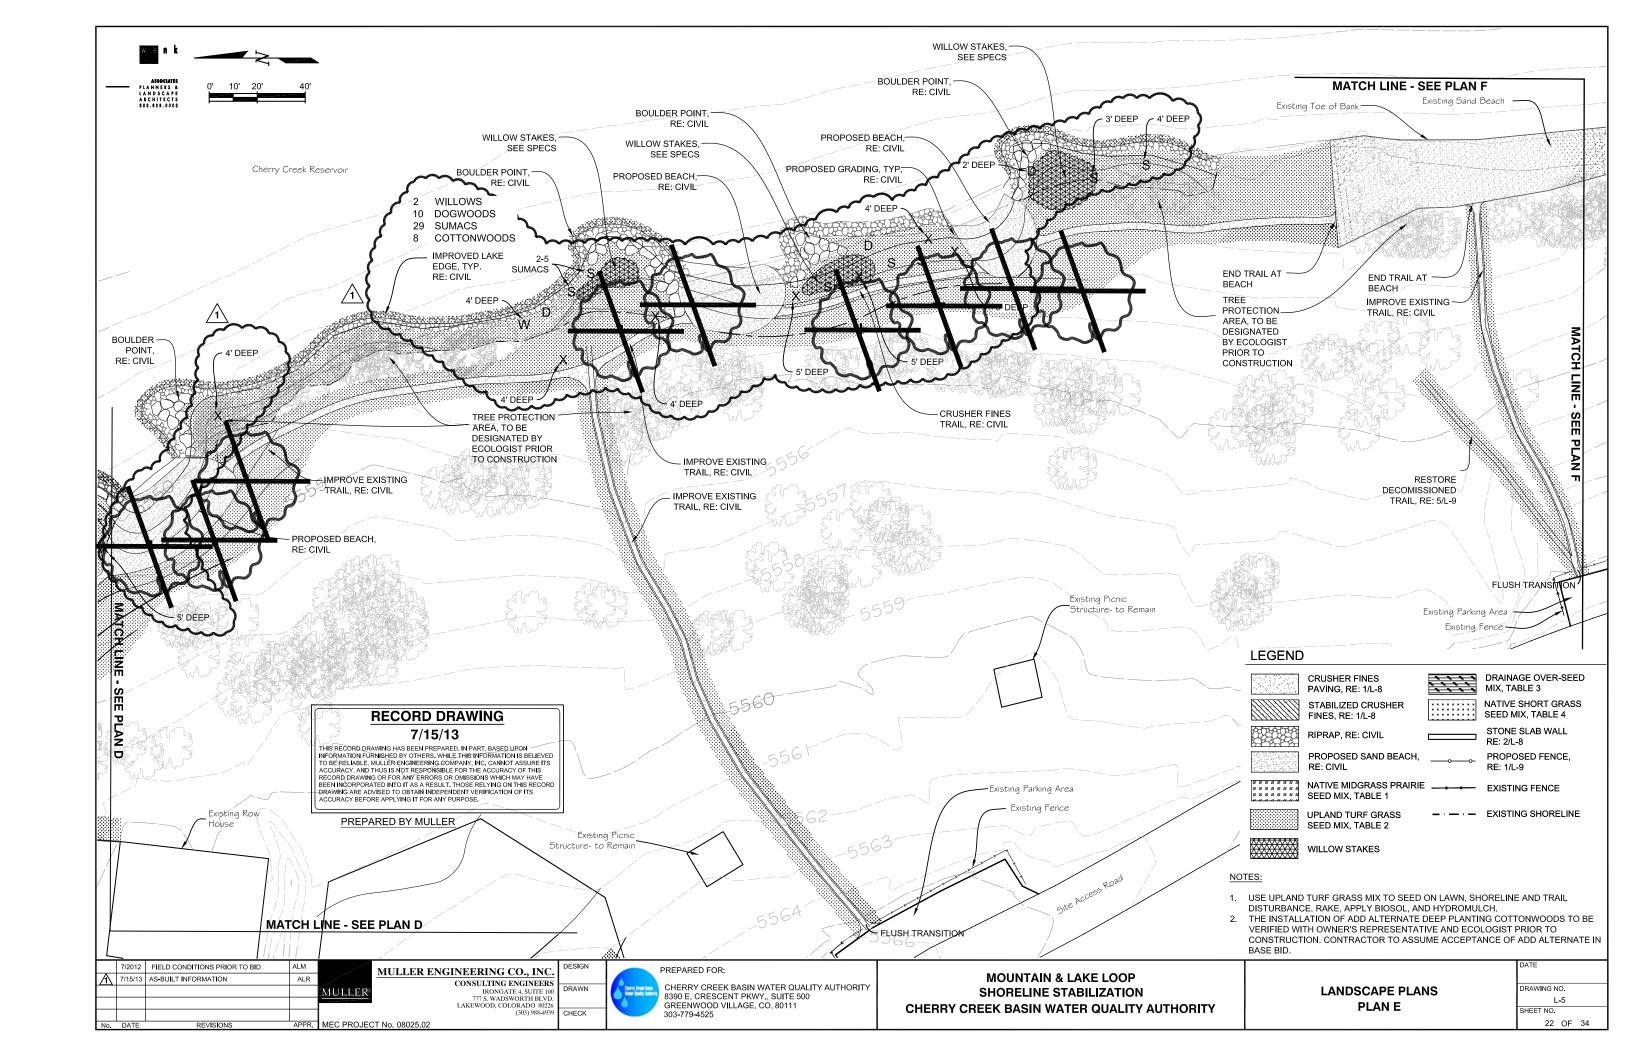

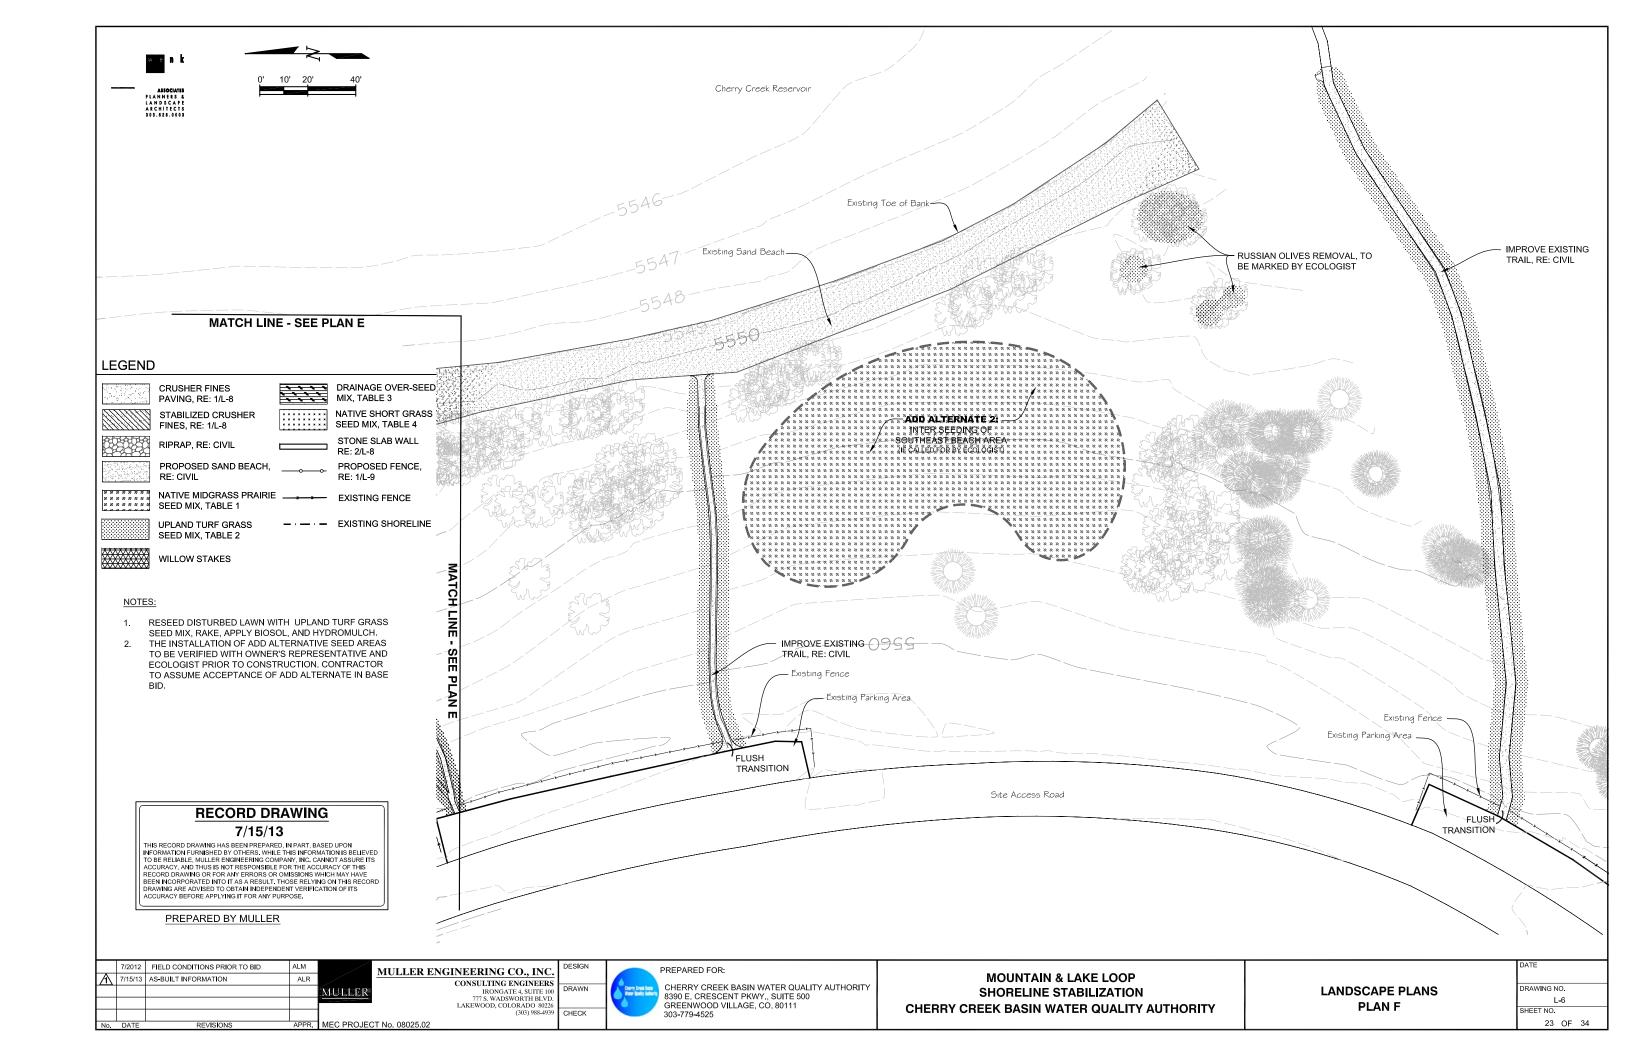

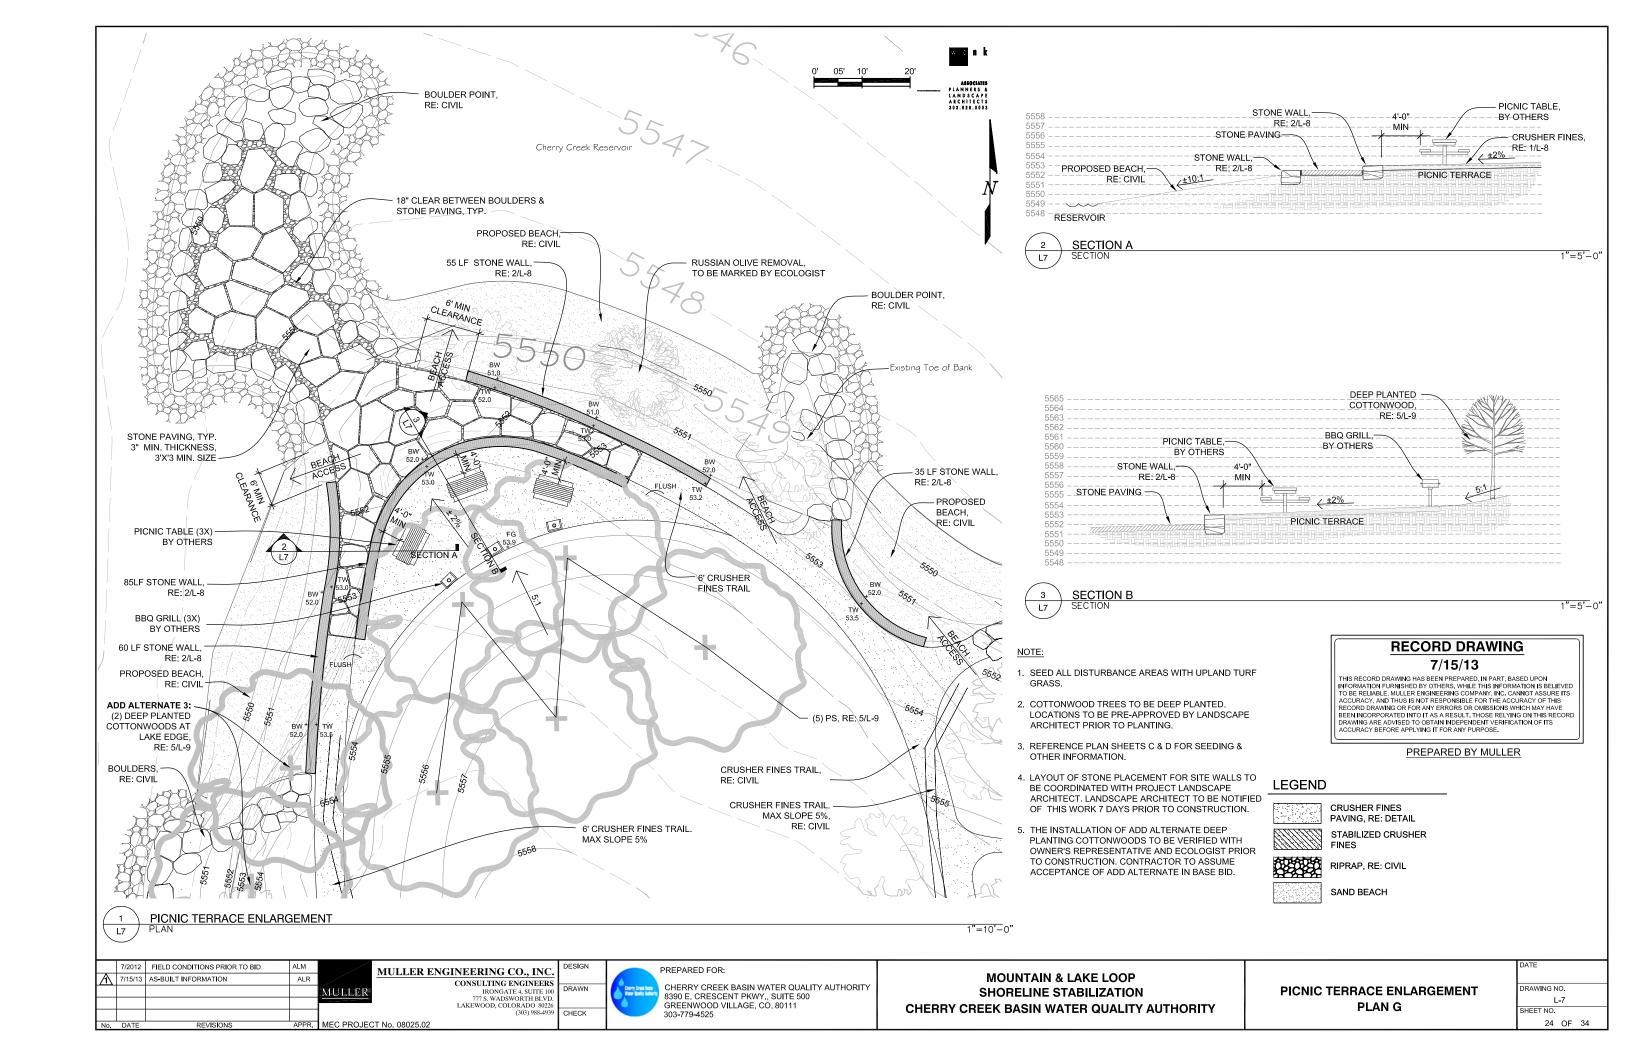




### RECORD DRAWING


### 7/15/13

THIS RECORD DRAWING HAS BEEN PREPARED, IN PART, BASED UPON INFORMATION FURNISHED BY OTHERS. WHILE THIS INFORMATION IS BELIEVED TO BE RELIABLE, MULLER ENGINEERING COMPANY, INC, CANNOT ASSURE ITS ACCURACY, AND THUS IS NOT RESPONSIBLE FOR THE ACCURACY OF THIS RECORD DRAWING OR FOR ANY FERORS OR OMISSIONS WHICH MAY HAVE BEEN INCORPORATED INTO IT AS A RESULT, THOSE RELYING ON THIS RECORD DRAWING ARE ADVISED TO OBTAIN INDEPENDENT VERIFICATION OF ITS ACCURACY BEFORE APPLYING IT FOR ANY PURPOSE.

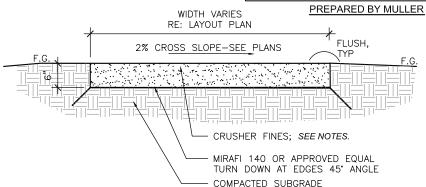

### NOTES:

- 1. CRUSHER FINES PAVING SHALL BE PLACED IN (2) 3" LIFTS MIN.
- 2. INSTALL CRUSHER FINES PAVING FLUSH WITH ADJACENT HARDSCAPE, TYP.
- 3. CRUSHER FINES IN AREAS STEEPER THAN 3% SHALL BE STABILIZED.

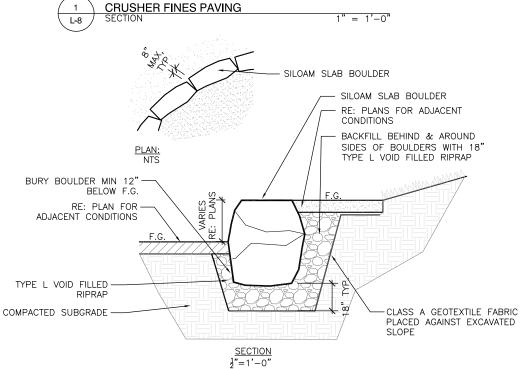



NOTES:

INSTALLER ROCK CAN BE USED AS WEDGES OCCASIONALLY ALONG FRONT FACE TO HELP INTERLOCK/STABILIZE BOULDERS AND FILL VOIDS BETWEEN BOULDERS BUT NEEDS TO BE SUFFICIENTLY LOCKED—IN SO THAT IT WILL NOT FALL OUT

2. CHINK ALL VOIDS GREATER THAN 4-INCHES BETWEEN LARGE BOULDERS FROM BEHIND WITH 9" TO 12" ROCK TO INSURE STABILITY AND THE APPEARANCE OF A SOLID ROCK WALL AND TO INSURE THAT THE TYPE VL VOID-FILLED RIPRAP BACKFILL DOES NOT FALL OUT FROM BEHIND THE BOULDER WALL.



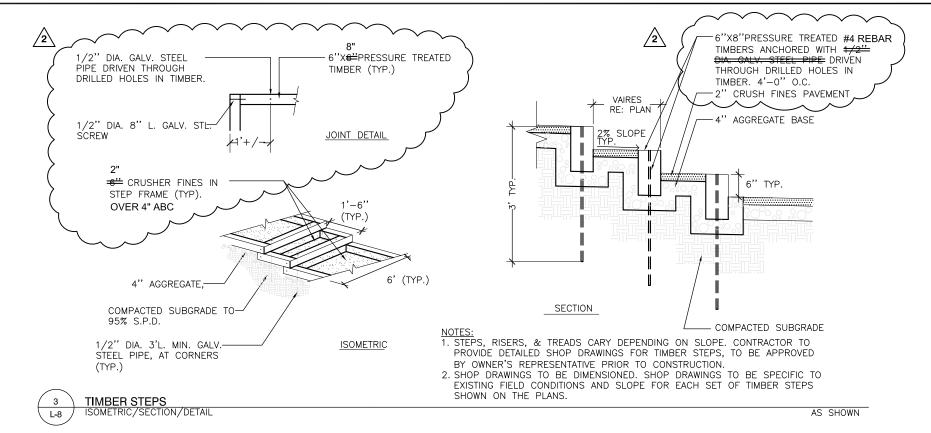

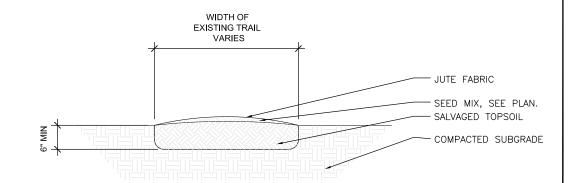

### NOTES:


- 1. DECOMPACT TRAIL TO 6" DEPTH.
- 2. APPLY SALVAGED (APPROVED) TOPSOIL TO SLIGHTLY OVERFILL DEPRESSED TRAIL.
- 3. LIGHTLY RECOMPACT.
- 4. SEED WITH SEED MIX INDICATED ON PLAN, RAKE TO COVER SEED, BIOSOL, JUTE NETTING, HYDROMULCH. INSTALL CUT OFF SLOTS ON SLOPES >5:1 10' O.C.

AS SHOWN

 INSTALL WATER BARS TO DRAIN AWAY FROM TRAIL AS INDICATED BY ENGINEER.





7/2	012 FIELD CONDITIONS PRIOR TO BID 5/13 AS-BUILT INFORMATION	ALM ALR ZMUEZ	MULLER ENGINEERING CO., INC.  CONSULTING ENGINEERS IRONGATE 4, SUITE 100 777 S. WADSWORTH BLVD. LAKEWOOD, COLORADO 80226 (30) 988-4939	DESIGN DRAWN CHECK	Deny Dred Son How Solly Inde	PREPARED FOR:  CHERRY CREEK BASIN WATER QUALITY AUTHORITY 8390 E. CRESCENT PKWY., SUITE 500 GREENWOOD VILLAGE, CO. 80111 303-779-4525	MOUNTAIN & LAKE LOOP SHORELINE STABILIZATION CHERRY CREEK BASIN WATER QUALITY AUTHORITY	SITE DETAILS	DRAWING NO. L-8 SHEET NO.	-
No. DA	TE PEVISIONS	APPR MEC. PRO	OJECT No. 08025 02	CHECK		303-779-4525			25 OF 34	

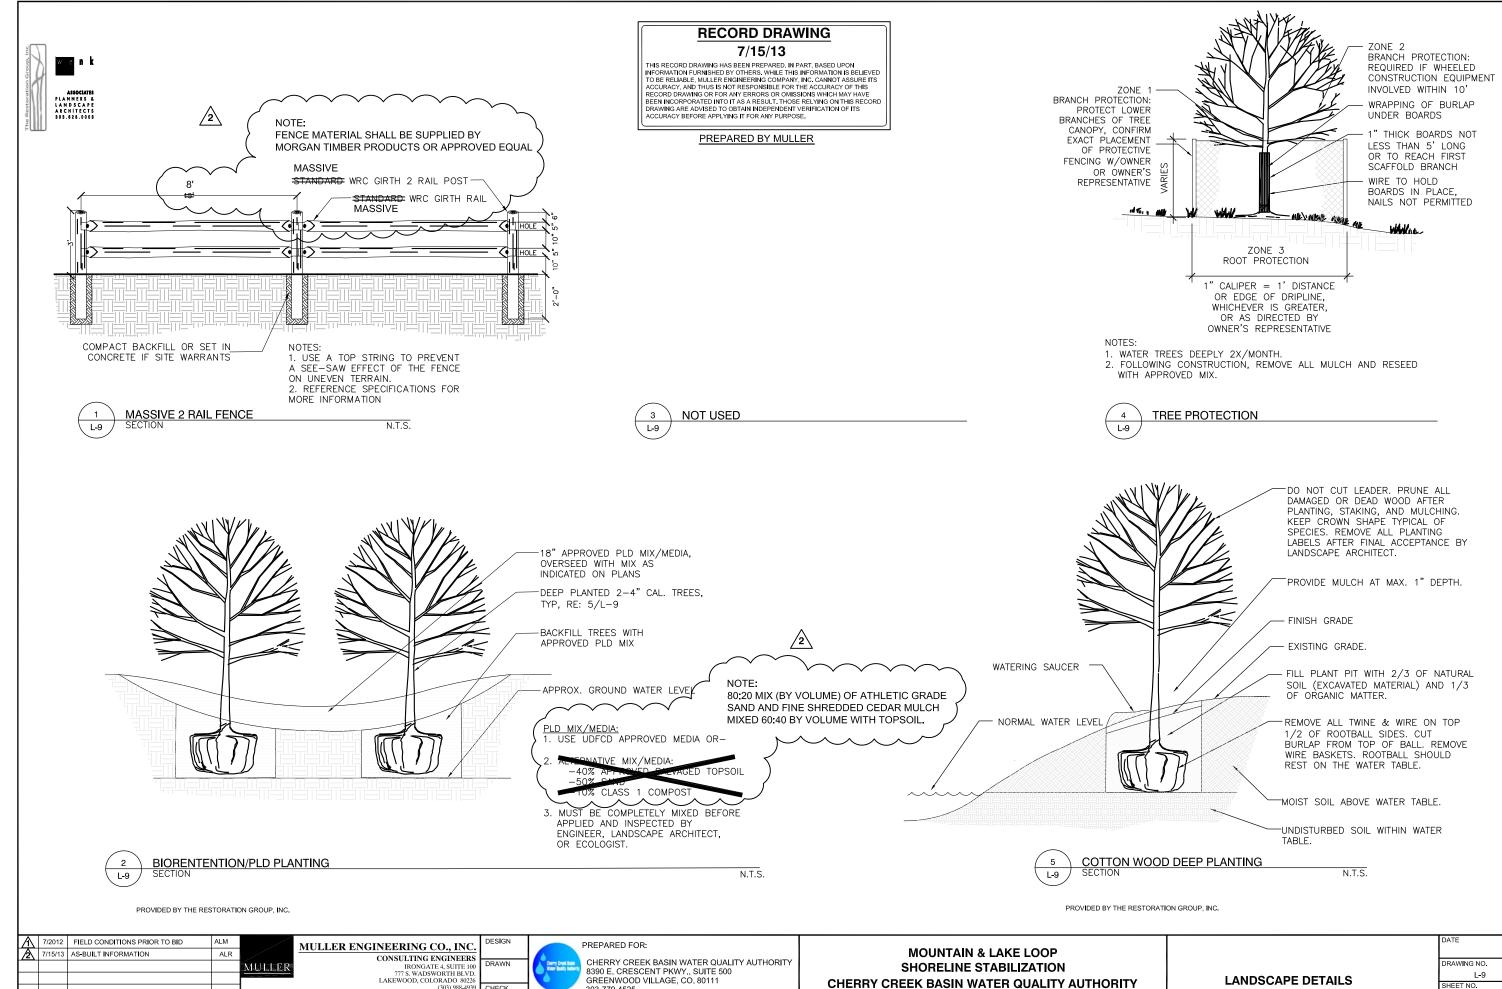



APPR. MEC PROJECT No. 08025.02


LANDSCAPE DETAILS

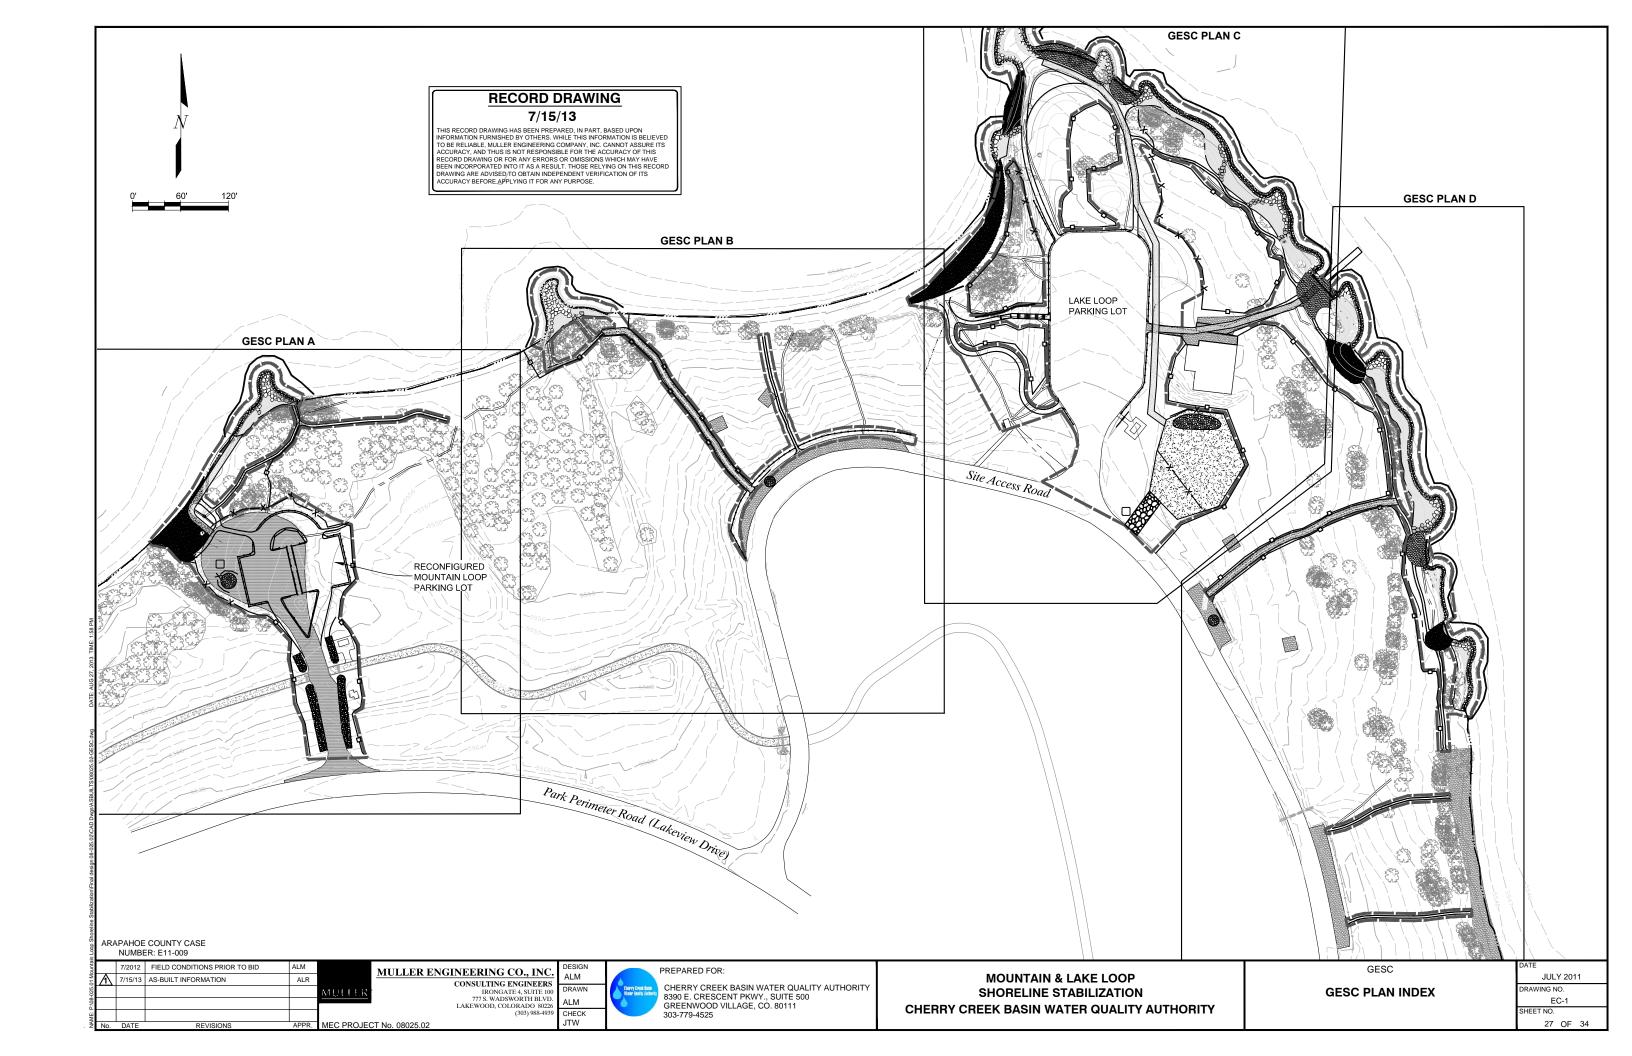

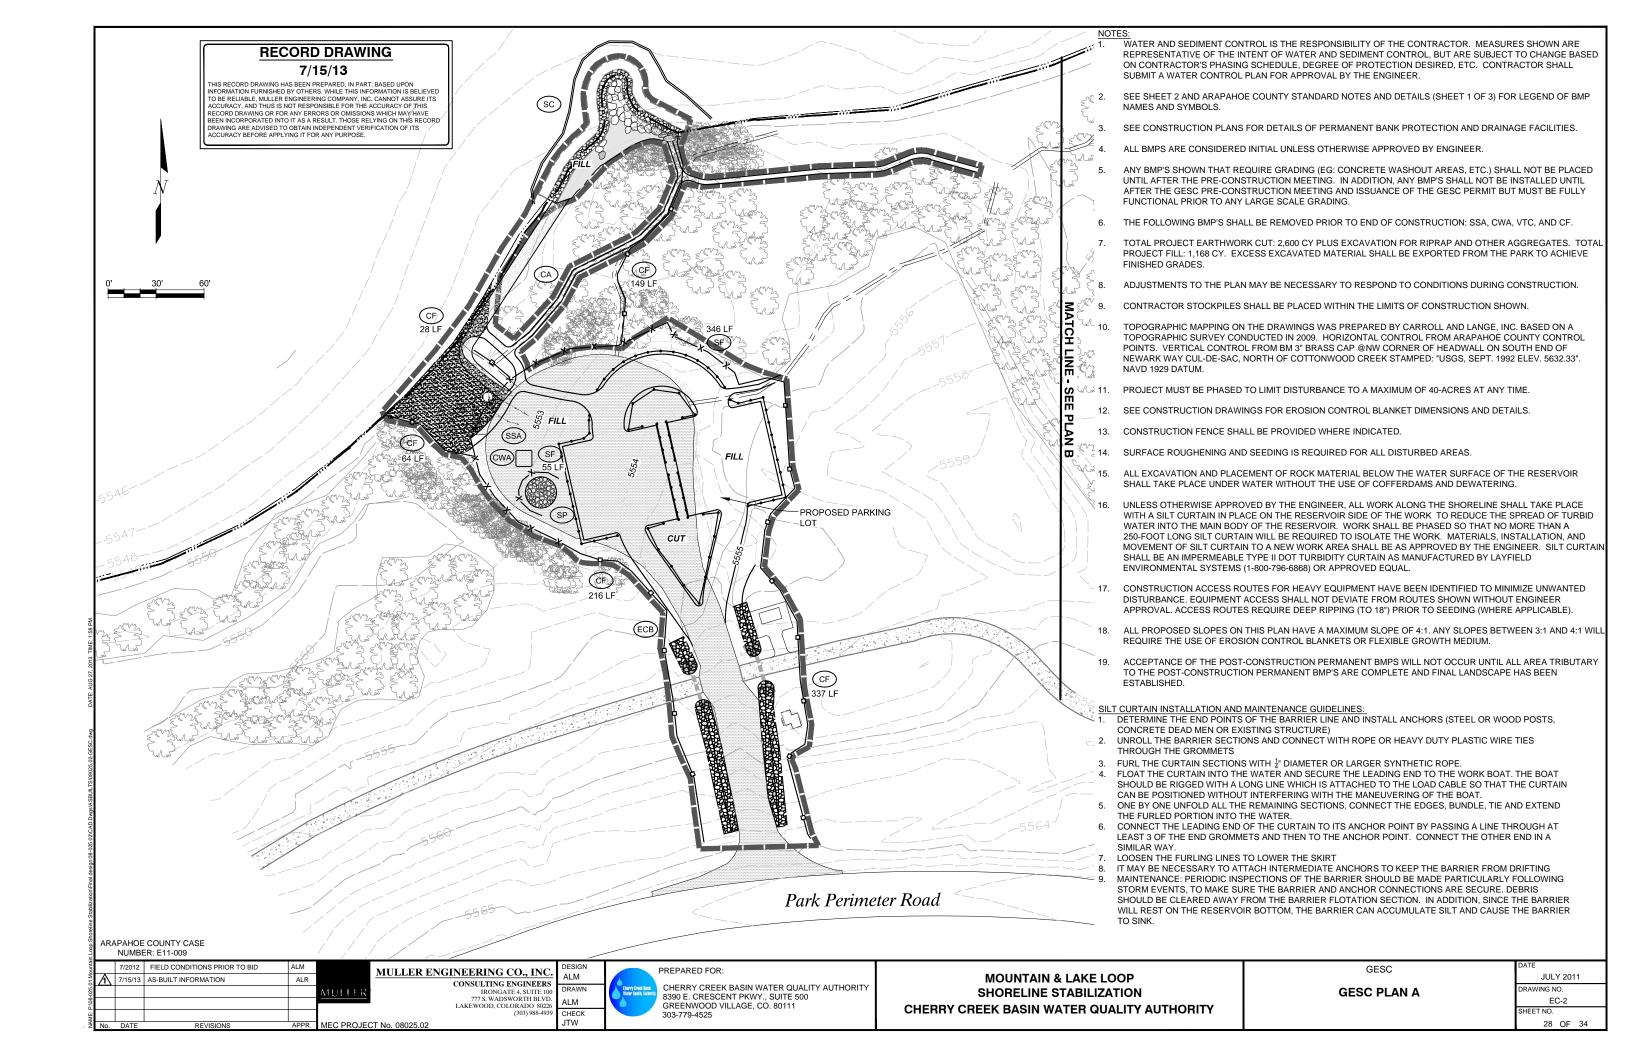

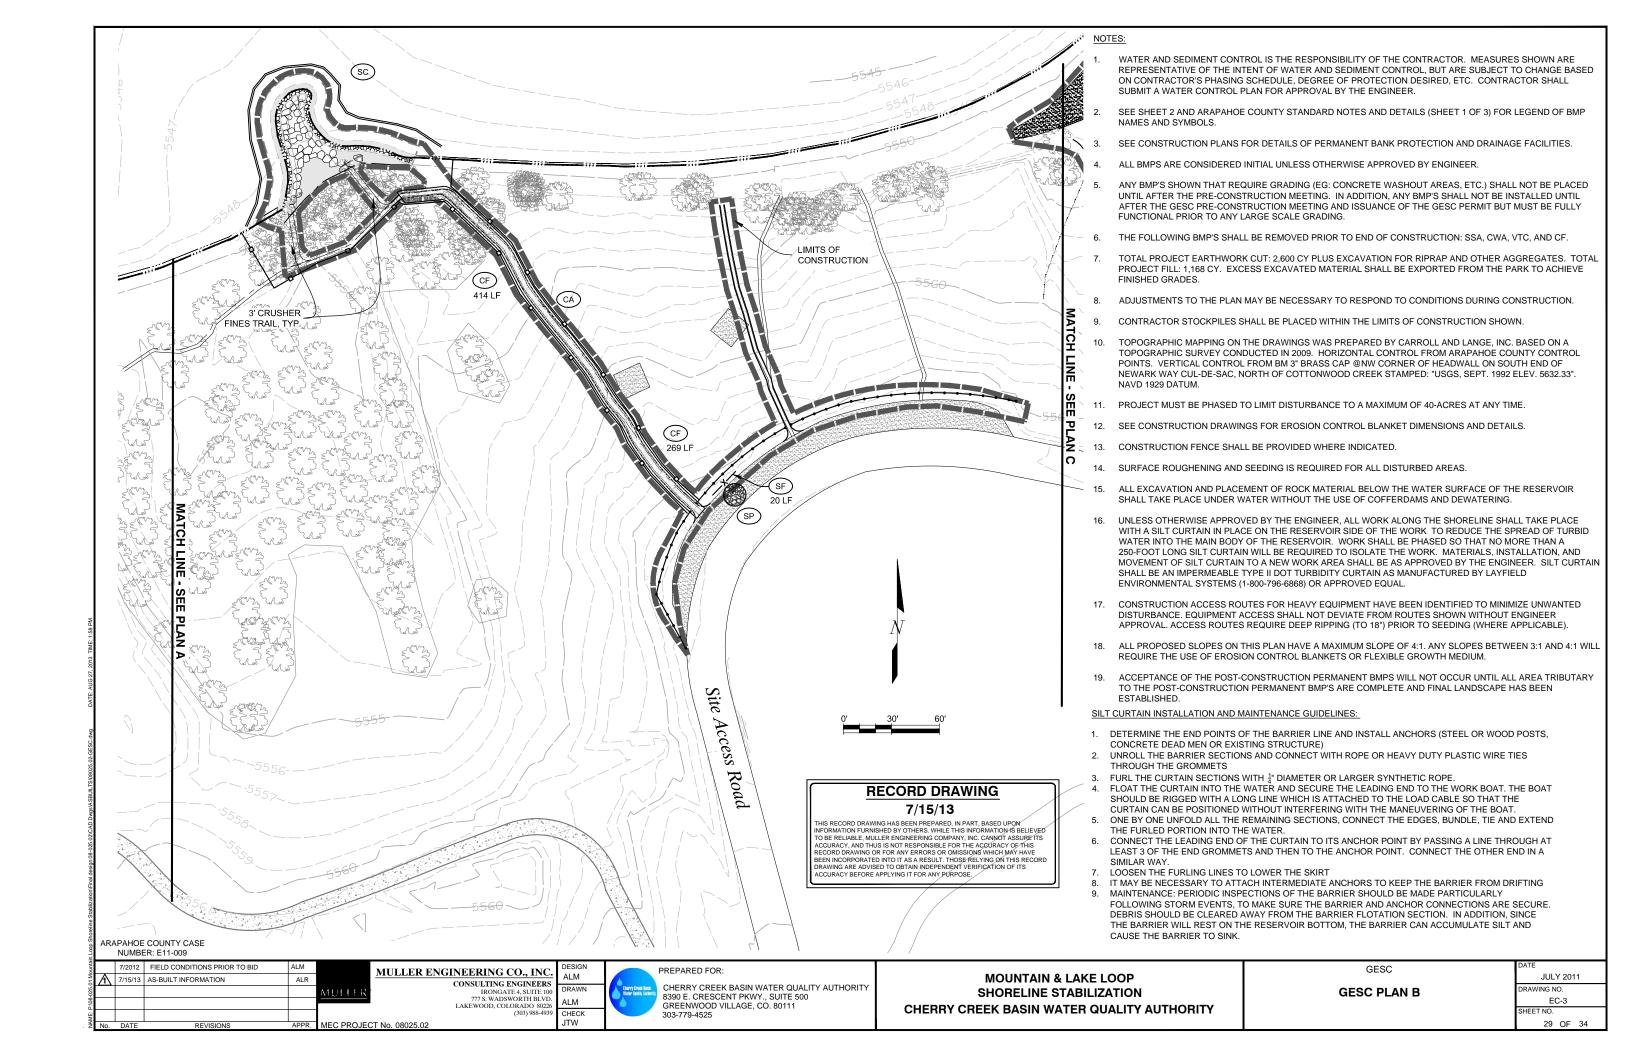

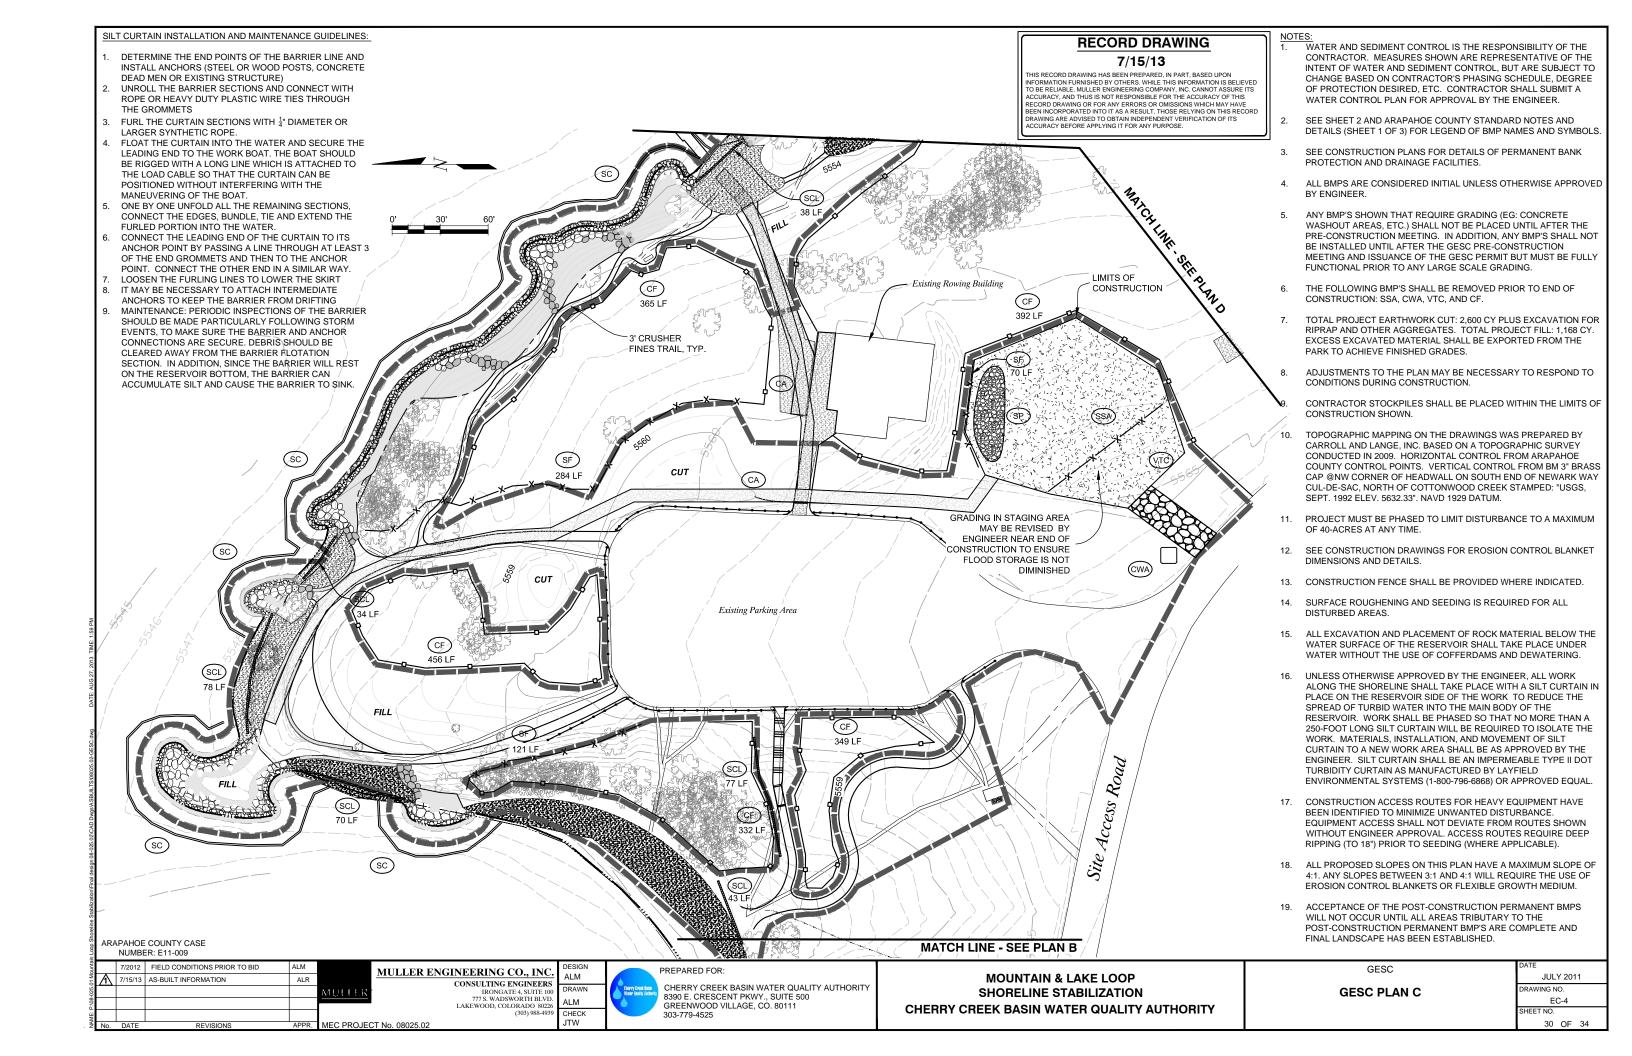

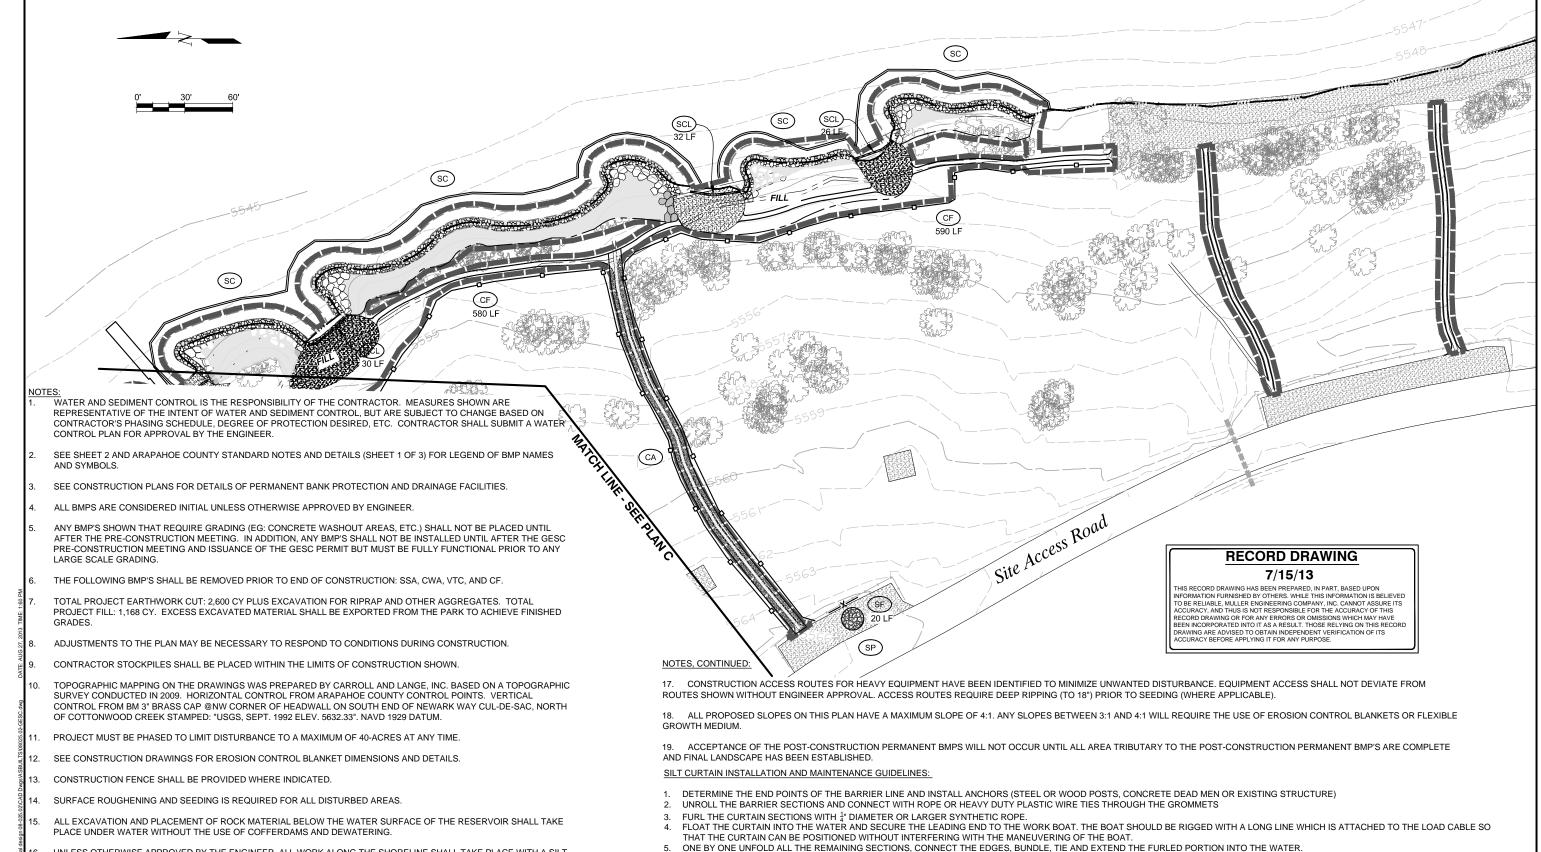

OTHER END IN A SIMILAR WAY

LOOSEN THE FURLING LINES TO LOWER THE SKIRT

ACCUMULATE SILT AND CAUSE THE BARRIER TO SINK

IT MAY BE NECESSARY TO ATTACH INTERMEDIATE ANCHORS TO KEEP THE BARRIER FROM DRIFTING

UNLESS OTHERWISE APPROVED BY THE ENGINEER, ALL WORK ALONG THE SHORELINE SHALL TAKE PLACE WITH A SILT CURTAIN IN PLACE ON THE RESERVOIR SIDE OF THE WORK. TO REDUCE THE SPREAD OF TURBID WATER INTO THE MAIN BODY OF THE RESERVOIR. WORK SHALL BE PHASED SO THAT NO MORE THAN A 250-FOOT LONG SILT CURTAIN WILL BE REQUIRED TO ISOLATE THE WORK. MATERIALS, INSTALLATION, AND MOVEMENT OF SILT CURTAIN TO A NEW WORK AREA SHALL BE AS APPROVED BY THE ENGINEER. SILT CURTAIN SHALL BE AN IMPERMEABLE TYPE II DOT TURBIDITY

CURTAIN AS MANUFACTURED BY LAYFIELD ENVIRONMENTAL SYSTEMS (1-800-796-6868) OR APPROVED EQUAL. ARAPAHOE COUNTY CASE

APPR. MEC PROJECT No. 08025 02

NUMBER: E11-009

7/2012 FIELD CONDITIONS PRIOR TO BID MULLER ENGINEERING CO., INC. 7/15/13 AS-BUILT INFORMATION ALR CONSULTING ENGINEERS IRONGATE 4, SUITE 100 LAKEWOOD, COLORADO 80

ALM AI M

PREPARED FOR: CHERRY CREEK BASIN WATER QUALITY AUTHORITY 8390 E. CRESCENT PKWY., SUITE 500 GREENWOOD VILLAGE, CO. 80111 303-779-4525

**MOUNTAIN & LAKE LOOP** SHORELINE STABILIZATION **CHERRY CREEK BASIN WATER QUALITY AUTHORITY** 

CONNECT THE LEADING END OF THE CURTAIN TO ITS ANCHOR POINT BY PASSING A LINE THROUGH AT LEAST 3 OF THE END GROMMETS AND THEN TO THE ANCHOR POINT. CONNECT THE

MAINTENANCE: PERIODIC INSPECTIONS OF THE BARRIER SHOULD BE MADE PARTICULARLY FOLLOWING STORM EVENTS, TO MAKE SURE THE BARRIER AND ANCHOR CONNECTIONS ARE

SECURE. DEBRIS SHOULD BE CLEARED AWAY FROM THE BARRIER FLOTATION SECTION. IN ADDITION, SINCE THE BARRIER WILL REST ON THE RESERVOIR BOTTOM, THE BARRIER CAN

**GESC GESC PLAN D**  JULY 2011 EC-5

- 2. THE ADEQUACY OF THIS GESC PLAN LIES WITH THE ORIGINAL DESIGN ENGINEES
- THE GESC PLAN SHALL BE CONSIDERED VALID FOR TWO (2) YEARS FROM THE DATE OF ACCEPTANCE BY ARAPAHOE COUNTY, FATER WHICH TIME THE PLAN SHALL BE VOID AND WILL BE SUBJECT TO RE-REVIEW AND RE-ACCEPTANCE B ARAPAHOE COUNTY, PLANS MUST CONFORM TO CURRENT REQUIREMENTS.
- THE PLACEMENT OF EROSION AND SEDIMENT CONTROL BEST MANAGEMENT PRACTICES (BMPs) SHALL BE IN ACCORDANCE WITH THE ARAPAHOE COUNTY ACCEPTED GESC PLAN AND THE ARAPAHOE COUNTY GESC MANUAL
- ANY VARIATION IN MATERIAL, TYPE OR LOCATION OF EROSION AND SEDIMENT CONTROL BMP8 FROM THE ARAPA COUNTY ACCEPTED GESC PLAN WILL REQUIRE APPROVAL FROM AN ACCOUNTABLE REPRESENTATIVE OF THE ARAPAHOE COUNTY ENGINEERING DIVISION.
- AFTER THE GESC PLAN HAS BEEN ACCEPTED, THE GESC PERMIT APPLIED FOR THE GESC FIELD MANUAL OBTAINED AT REVIEWED, THE CONTRACTOR MAY INSTALL THE INITIAL—STAGE EROSION AND SEDIMENT CONTROL BMPS INDICATED ON THE ACCEPTED GESC PLAN.

- CONSTRUCTION SHALL NOT BEGIN UNTIL THE ARAPAHOE COUNTY CESC INSPECTOR APPROVES THE INSTALLATION OF THE INTIAL BURPS AND THE APPROVED CESC PERMIT IS PICKED UP FROM THE COUNTY AND IS IN-HAND ON THE SITE. THE COMPLETED PERMIT MILL BE AVAILABLE WITHIN 24-HOURS AFTER THE INSTALLATION OF THE INTIAL BURPS ARE

- ALL CONSTRUCTION TRAFFIC MUST ENTER/EXIT THE SITE THROUGH THE ARAPAHOE COUNTY-APPROVED ACCESS POINT A VEHICLE TRACKING CONTROL PAD IS REQUIRED AT ALL ACCESS POINTS ON THE SITE. ADDITIONAL STABILIZED CONSTRUCTION ENTRANCES MAY BE ADODE WITH AUTHORIZATION FROM THE ARAPAHOE COUNTY ENGINEERING SERVICES



- SEE PLAN VIEW FOR:
   LOCATIONS OF CONCRETE WASHOUT AREA.
- 2. THE CONCRETE WASHOUT AREA SHALL BE INSTALLED PRIOR TO ANY CONCRETE PLACEMENT ON SITE.
- 3. VEHICLE TRACKING CONTROL (DETAIL 26) IS REQUIRED AT THE ACCESS FORM.

CWA CONCRETE WASHOUT AREA (4)

----- CF CONSTRUCTION FENCE (5) CM CONSTRUCTION MARKERS (6)

MDC

DRAWN


ALM

CHECK JTW

22. STRAW BALES ARE NOT A ARAPAHOE COUNTY GESC-ACCEPTED SEDIMENT CONTROL BMP.

- 34. ALL DEWATERING ON SITE SHALL BE COORDINATED WITH A ARAPAHOE COUNTY GESC INSPECTOR AND BE FREE OF SECURIOR IN ACCORDANCE WITH THE CESC CRITERIA MANUAL.
- ALL PERMANENT INSTALLATIONS OF PIPES FOR STORM SEWERS, SLOPE DRAINS, AND CULVERTS, TOGETHER WITH RIPRA APRONS OR OTHER INLET AND CUTLET PROTECTION, REQUIRE INSPECTION BY ARAPAHOE COUNTY ENGINEERING (SEPHARTE FROM GESC INSPECTIONS).

- ALL SINGLE FAMILY RESIDENTIAL PROJECTS SHALL COMPLY WITH THE GESC MANUAL, SECTION 9, THROUDUILDING PERMIT PROGESS.

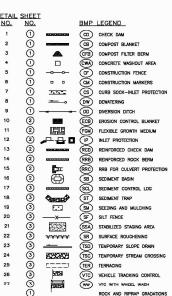

LIMITS OF CONSTRUCTION

MINIMUM -

- WIRE OR FILTER FABRIC-ENCLOS 1-1/2" CRUSHED ROCK

 ADDITIONAL CURB SOCKS MAY BE REQUIRED ON THE DESKIN PLANS OR DURING CONSTRUCTION AS DIRECTED BY ARAPANICE COUNTY AND/OR AUTHORIZED AGENTS. 

. INTERIU CONFIGURATION OF CURB SOCKS IN STREETS SWALL BE INSTALLED WITHIN 48-HOURS OF POLICING CURBS. CURB SOCKS (AFTER PAYABLEY!) SWALL BE INSTALLED WITHIN 48 HOURS AFTER PAYAB IS PLACED.

5. CRUSHED ROCK SHALL BE FRACTURED FACE (ALL SIDES) AND SHALL COMPLY WITH GRADATION SHOWN ON SHEET 1  $(1-1/2^n$  Minus), RECYCLED CONCRETE WEETING THIS GRADATION MAY BE USED.

7. WIRE MESS SHALL BE FARROTED OF 10 GAUGE WIRE TWISTED INTO A NESH WITH A MAXIMUM OFFINING OF 1.0 HIGH (COMMONLY TERMED "CHOOSEN WIRE"), ROLL WITH SHALL BE 48-HIGHES.

8. WIRE MESS SHALL BE SEQUEDED USING TOO RINGS" OR WIRE TES AT 6-HIGH CENTERS ALONG ALL AURITS AND AT 24-HIGH CHOTHES ON BUSS OF BETAL.

THE GESC MANAGER SHALL INSPECT CURS PROTECTION WEEKLY, DURING AND AFTER ANY STORM EVENT AND MAKE REDWING OR CLION OUT AS INCCESSARY. MORE PRODUCT INSPECTIONS AND REPAIRS SHALL BE REQUIRED COMING WHEREO DOHNMONE OUT OF INCCESSARY PRODUCT. SEDMENT ACCUMULATED SPSTREAM OF CURB SOCK SHALL BE REMOVED WHEN THE SEDMENT DEPTH UPSTREAM OF ROCK BERM IS WITHIN 2-1/2 INCHES OF THE CREST.

CURB PROTECTION IS TO REMAN IN PLACE UNTIL THE UPSTREAM DISTURBED AREA IS STABILIZED AND GRASS COVER IS APPROVED, UNLESS SEMSMA APPROVES EARLIER REMOVAL OF CLIER PROTECTION IN STREETS


CS CURB SOCK-INLET PROTECTION (7)

11. THE TOP OF REINFORCED ROOK BERM SHALL BE 1/2"-1" BELOW TOP OF CURB.

DB0=12" RIPRAP SEE THIS SHEET FOR GRADATION EE PLAN VIEW FOR:
- LOCATIONS OF CHECK DAMS.
- CHECK DAM TYPE (CHECK DAM OR REINFORCED CHECK DAM)
- LENGTH, "L", CREST LENGTH, "CL", AND DEPTH, "D".

- CHECK DAMS INDICATED ON INITIAL GESC PLAN SHALL BE INSTALLED AFTER CONSTRUCTION FENCE BUT PRICE TO ANY UPSTREAM LAND-DISTURBING ACTIVITIES.
- i. The ends of the check dam shall be a minimum of 1'-6" higher than the center of the check dam.
- HECK DAM MAINTENANCE NOTES

  1. THE GESC MANAGER SHALL INSPECT CHECK DAMS WEEKLY, DURING AND AFTER MAY STORM EVENT
  AND DAMS REPAIRS OR CLEAN OUT AS NECESSARY. SEDIMENT ACCUMULATED UPSTREAM OF CHECK DAMS SHALL BE REMOVED WHEN THE SEDIMENT DEPTH UPSTREAM OF CHECK DAM IS WITHIN \$ OF THE HEIGHT OF THE CREST.
- CHECK DAMS ARE TO REMAIN IN PLACE UNTIL THE UPSTREAM DISTURBED AREA IS STABILIZED AND GRASS COVER IS APPROVED BY THE COUNTY.
- . WHEN CHECK DAMS ARE REMOVED, EXCAVATIONS SHALL BE FILLED WITH SUITABLE COMPACTED BACK FILL ANY DISTURBED AREA SHALL BE SEEDED AND MULCHED AND COVERED WITH EROSION CONTROL BLANKET OR OTHERWISE STABLIZED IN A MANNER APPROVED BY THE COUNTY.

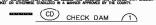




LOWEST SUBGRADE ELEVATION TO BE DEWATERE — PLASTIC 5—GALLON BUCKET WITH 3/8" HOLES DRILLED AT 2" MAX. SPACING IN SIDE AND BOTTOM



TEMPORARY SETTLING BASINS SHALL BE REMOVED WHEN NO LONGER NEEDED FOR DEWATERING OPERATIONS. ANY DISTURBED AREA SHALL BE DRILL SEEDED AND CRIMP MULCHED OR OTHERWIS STABILIZED IN A MANNER APPROVED BY THE COLUMY.

DEWATERING (8)

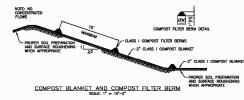

- MAY BE USED IN PLACE OF STRAW MULCH OR EROSION CONTROL BLANKET IN AREAS WHERE ACCESS IS DEFICULT DUE TO LANDSCAPING OR OTHER OBJECTS OR IN AREAS WHERE A SMOOTH TURK GRASS FIRSH IS DESIRED.
- SHALL ONLY BE UTILIZED IN AREAS WHERE SHEET FLOW CONDITIONS PREVAL; SHALL BE PROHIBITED IN AREAS OF POSSIBLE CONCENTRATED FLOW.
   SOIL PREPARATION SHALL BE COMPLETE PER THE SPECIFICATIONS CUITLINED IN THESE CRITERIA PRIOR TO APPLICATION.
- 5. WHEN TUSE GRASS FINISH IS NOT DESIRED, SURFACE ROUGHENING ON SLOPES SHALL TAKE PLACE PRIOR TO APPLICATION.
- 7. MAY BE APPLIED UTILIZING PREDMAND BEDWEN, OF BY TANKS.
  8. SEEDING SHALL BE DRILLED PRIOR TO THE APPLICATION OF COMPOST OR SEED MAY BE COMBINED AND BLOWN WITH THE PREDMAND BLOWER.
- COMPOST PILER BESS SHALL BE UTILIZED ON SLOPES WITH A MAXIMUM SPACING OF 16 PEET PER THE REQUIREMENTS FOUND IN THE COMPOST FILER BESS SECTION.
   THE GESS MANGER SHALL INSPECT WESLLY, DURING AND AFTER ANY STORM EVERT.

PARAMETERS	LOWING PHYSICAL, CHEMICAL, AND BIOLOGICAL P.  CLASS I COMPOST FOR COMPOST BLANKET
MINIMUM STABILITY INDICATOR	STABLE TO VERY STABLE
SOLUBLE SALTS	MAXIMUM 5mmhos/cm
PH	6.0 - 8.0
AG INDEX	> 10
MATURITY INDICATOR EXPRESSED AS PERCENTAGE OF GERMINATION/VIGOR	80+/80+
MATURITY INDICATOR EXPRESSED AS AMMONIA N/ NITRATE N RATIO	< 4
MATURITY INDICATOR EXPRESSED AS CARBON TO HITROCEN RATIO	20:1
TESTED FOR CLOPYRALID	YES/NEGATIVE RESULT
MOISTURE CONTENT	30-50 %
ORGANIC MATTER CONTENT	25-45 % OF DRY WEIGHT
PARTICLE SIZE DISTRIBUTION	3" (75mm) 100% PASSING 1" (25mm) 95% TO 100% PASSING 3/4" (19mm) 85% TO 90% PASSING 3/8" (9,5mm) 50% TO 60% PASSING 44 20 TO 35% PASSING
PRIMARY, SECONDARY NUTRIENTS:	MUST RE REPORTED

TESTING AND TEST REPORT SUBMITTAL STA + CLOPYRALID MOS. LILLER...

AND L

CB) COMPOST BLANKET (2)

"W" (5'-0" MIN.)

FOR ECB LINED DITCHES, INSTALLATION OF EROSION CONTROL BLANKET SHALL CONFORM TO THE REQUIREMENTS OF DETAIL 10.

DIVERSION DITCHES ARE TO REMAIN IN PLACE UNTIL THE END OF CONSTRUCTION, OR, IF APPROVED BY THE COUNTY, LEFT IN PLACE.

IF DIVERSION DITCHES ARE REMOVED, THE DISTURBED AREA SHALL BE DRILL SEEDED AND CRIMI MULCHED OR OTHERWISE STABILIZED IN A MANNER APPROVED BY THE COUNTY.

DD DIVERSION DITCH (9)

- COMPOST FATER BERN MOTES:

  1. SEE PAN YOU FOR LENGTH OF COMPOST FATER BERN.

  2. SHALL BE APPLED TO ALL SCHESS RECEINING A COMPOST BLANKET AT 15' INCRE.

  3. FILTER BERNES SHALL RUN PAPALLEL, TO THE CONTOUR.

  4. FILTER BERNES SHALL BE A MANUAL OF 1' H x 2' Hs.

  5. FILTER BERNES SHALL BE A MANUAL OF 1' H x 2' Hs.

  5. FILTER BERNES SHALL BE A MANUAL OT 1' H x 2' Hs.
- SHALL ONLY BE UTILIZED IN AREAS WHERE SHEET FLOW CONDITIONS PREVAL; SHALL BE PROHIBITED IN AREAS OF POSSIBLE CONCENTRATED FLOW.
   SOIL PREPARATION SHALL BE COMPLETE PER THE SPECIFICATIONS OUTLINED IN THESE CHIERAN PRIOR TO APPLICATION.
- WHEN TURF GRASS FINISH IS NOT DESIRED, SURFACE ROUGHENING ON SLOPES SHALL TAKE PLACE PRIOR TO APPLICATION.
- SEEDING SHALL BE DRILLED BEFORE THE APPLICATION OF COMPOST OR SEED MAY BE COMBINED AND BLOWN WITH THE PNEUMATIC BLOWER.

COMBINED AND BLOWN WITH THE PNEUMATIC BLOWER.

10. THE GESC MANAGER SHALL INSPECT WEBLLY, DURING AND AFTER ANY STORM EVENT.

11. COMPOST USED IN THE APPLICATION OF THE COMPOST BLANKET SHALL BE A CLASS.

COMPOST AS DETINED BY THE FOLLOWING PHYSICAL CHEMICAL. AND BIOLOGICAL PAR

S: F.A. BOSCALIO COMPOST IS TO BE JITULED IT SHALL BE PRODUCED BY A FACILITY IN PROSESSIONOUS OF A FACILITY IN PROJECT OF NOTE: A LAB TEST DETAILING THE CHEMICAL, PHYSICAL, AND BIOLOGICAL PARAMETERS SHALL BE PROVIDED UPON REQUEST BY ARAPANIOE COUNTY.

▲ CFB COMPOST FILTER BERM (3)



DEG MEDIAN % OF MATERIAL TYPICAL STONE TYPICAL STONE SIZE SMALLER THAN EQUIVALENT (NCHES) TYPICAL STONE DIAMETER (NCHES) 70 - 100 50 - 70 35 - 50 2 - 10 70 - 100 50 - 70 35 - 50 2 - 10 440 275 85 100 50 - 70 35 - 50 2 - 10 30 24 18 6 1280 650 275 100 50 - 70 35 - 50 2 - 10 3500 1700 650 35

SIEVE SIZE	MASS PERCEI PASSING SQUA MESH SIEVE
	CLASS A
3*	100
1 1/2"	20 - 90
NO. 4	0 - 20
NO. 200	0 - 3

SIEVE SIZE	MASS PERCENT PASSING SQUARE MESH SIEVES
	NO. 4
2"	100
1 1/2"	90 - 100
17	20 - 55
3/4"	0 - 15
3/8*	0 - 5
COARSE AGG PER AASHTO	CIFICATIONS FOR NO. 4 REGATE FOR CONCRETE M43. ALL ROCK SHALL RED FACE, ALL SIDES.

SHEET 1 OF 3

Arapahoe Countv Colorado's First

DEPARTMENT OF PUBLIC WORKS AND DEVELOPMENT -ENGINEERING SERVICES DIVISION GESC GRADING, EROSION, AND SEDIMENT CONTROL

**GESC PLAN** STANDARD NOTES AND DETAILS JANUARY 2005. REVISED JANUARY 2010

**GESC DETAILS** 

7/2012 FIELD CONDITIONS PRIOR TO BID ALM MULLER APPR. MEC PROJECT No. 08025.02

MULLER ENGINEERING CO., INC. CONSULTING ENGINEERS

EE PLAN VIEW FOR:
- TYPE OF CONSTRUCTION LIMIT INDICATOR (FENCE OR MARKERS).
- LOCATION AND LENGTH OF FENCE OR LINE OF MARKERS.

CONSTRUCTION FENCE OR MARKERS INDICATED ON INITIAL GESC PLAN SHALL E INSTALLED PRIOR TO OTHER BMPS AND ANY LAND—DISTURBING ACTIVITIES.


FENCE OR MARKERS SHALL BE REMOVED AT THE END OF CONSTRUCTION. IF ANY DISTURBED AREA EXISTS AFTER FENCE REMOVAL, IT SHALL BE ORELL SEEDED AND CRIMP MULCHED OR OTHERWISE STRABLIZED IN A MANNER APPROVED BY THE


777 S. WADSWORTH BLVI LAKEWOOD, COLORADO 80226 (303) 988-4939 PREPARED FOR

CHERRY CREEK BASIN WATER QUALITY AUTHORITY 8390 E. CRESCENT PKWY., SUITE 500 GREENWOOD VILLAGE, CO. 80111

**MOUNTAIN & LAKE LOOP** SHORELINE STABILIZATION **CHERRY CREEK BASIN WATER QUALITY AUTHORITY** 

JULY 2011 EC-6 32 OF 34

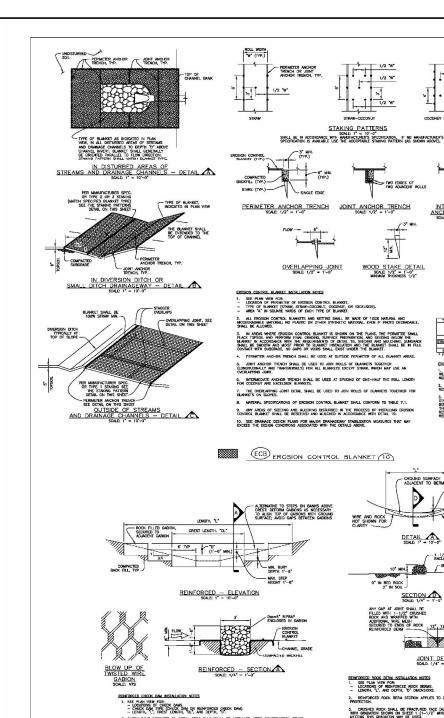

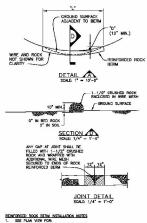

LOCATIONS OF REINFORCED ROCK BERMS. LENGTH, "L", AND DEPTH, "D" DIMENSIONS.

8. FOR CONCENTRATED FLOW AREAS THE ENDS OF THE REINFORCED ROCK BERM SHALL BE 12" HAMLEY HAM THE CENTER OF THE BERM.


REPRESENTATION OF THE STATE OF

RRB REINFORCED ROCK BERM (14)

MDC

ALM

CHECK JTW

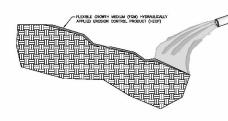

GENERAL GUIDELINES FOR APPLICATION RATES FOR SLOPE INSTALLATIONS		
SLOPE CONDITION	APPLICATION RATE	
≤3H:1V	3000 LB/ACRE	
BELOW ECB	1500 LB/ACRE	

NOTE: THE FLEXIBLE GROWTH MEDIUM SHOULD NOT BE APPLIED IN CHANNELS, SWALES OR OTHER AREAS WHERE CONCENTRATE FLOWS ARE ANTICIPATED, UNLESS INSTALLED IN CONJUNCTION WITH A TEMPORARY ENOSION CONTROL BLANCET.

FLEXIBLE GROWTH MEDIUM (11)


PPLY FGM FROM OPPOSING DIRECTIONS TO ASSURE 100% SO IRFACE COVERAGE. SLOPE DEVICES OR WATER DIVERSION INCHNIQUES ARE RECOMMENDED WHEN SLOPE LENGTHS EXCER ANY AREAS OF SEEDING AND MULCHING DISTURBED IN THI PROCESS OF INSTALLING FOM SHALL BE RESEEDED AND

THE GESC MANAGER SHALL INSPECT FLEXIBLE GROWTH MEDIUMS WEEKLY AND DURING AND AFTER ANY STORM EVENT AND MAKE


JOINT DETAIL SCALE: 1/4" = 1'-0"

AREA INLET - PLAN


SECTION C

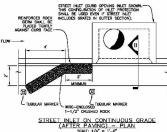

SECTION A

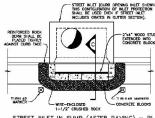

STREET INLET IN SUMP (AFTER PAVING) - PLAN

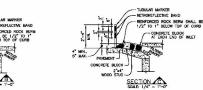

PROTECTION INSTALLATION, NOTES I INTERNI CONDIGUENCION OF HALT PROTECTION IN STREETS SHALL BE INSTALLED WITHIN 48-HOURS OF POURING INLET, INLE PROTECTION (AFTER PARKEMY) SHALL BE INSTALLED WITHIN 48 HOURS AFTER PAAIND IS PLACED.

2. INLET PROTECTION AT AREA INLETS SHALL BE INSTALLED WITHIN 48-HOURS OF POURING INLET.

 CRUSHED ROCK SHALL BE FRACTURED FACE (ALL SIDES) AND SHALL COMPLY WITH GRADATION SHOWN ON SHEET 1 (1-1/2"
MINUS). RECYCLED CONCRETE MEETING THIS GRADATION MAY BE USED. WIRE MESH SHALL BE FABRICATED OF 10 GAUGE WIRE TWISTED INTO A MESH WITH A MAXIMUM OPENING OF 1.0 INCH (COMMONLY TERMED "CHOKEN WIRE"), ROLL WIDTH SHALL BE 48-INCHES.

5. WHEE MESH SHALL BE SECURED USING THOU RINGS" OR WHEE TIES AT 8-MICH CENTERS ALONG ALL JOINTS AND AT 2-INC CENTERS ON ENGS OF BERM.

CENTES ON DIGGS OF BERM.

REPORTED THOSE OF STATE, BE CONSTRUCTED IN ONE PECE OR SHALL BE CONSTRUCTED USING JOHT DETAIL.


T. TUBULAR WARKES SHALL MEET REQUIREMENTS OF MANUAL DILIBRISHM TRAFFIC CONTROL DEVICES (MUTCO). AS AND-DED IS THE TOP O'R REMATRICED ROCK BERM SHALL BE 1/2\*-1\* BELOW TOP O'C URBS.

THE FOR PROFESSIONAL BOOK BOOK BOOK BY THE PROFESSION REPORT, DURING AND AFTER ANY STORM EVENT AND MAKER SHALL INSPECT MLET PROFESSION, MORE PROJUCT IN PROFESSIONAL BAPTER ANY STORM EVENT AND MAKER REPORTS ON CLEM OUT AS INCESSION, MORE PROJUCT INSPECTIONS AND REPORTS SHALL BE REQUIRED LURING WHITER COMPONIOUS OUT OF TREESTAND PROFESSION.

SEDIMENT ACCUMULATED UPSTREAM OF INLET PROTECTION SHALL BE REMOVED WHEN THE SEDIMENT DEPTH UPSTREAM OF ROCK BERM IS WITHIN 2-1/2 INCHES OF THE CREST.

3. INLET PROTECTION IS TO REMAIN IN PLACE UNTIL THE UPSTREAM DISTURBED AREA IS STABILIZED AND GRASS COVER IS APPROVED, UNLESS THE COUNTY APPROVES EXPLIER REMOVAL OF INLET PROTECTION IN STREETS.

WHEN INLET PROTECTION AT AREA INLETS ARE REMOVED, THE DISTURBED AREA SHALL BE DRILL SEEDED AND CRIMP MULCHED OR OTHERWISE STABILIZED IN A MANNER APPROVED BY THE COUNTY.

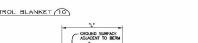

2. CHECK DAMS INDICATED ON INTIAL GESC PLAN SHALL BE INSTALLED AFTER CONSTRUCTION FENC BUT PRIOR TO ANY UPSTREAM LAND-DISTURBING ACTIVITIES. REMEMBER CHECK DAMES, GURSIONS SHALL HAVE GALVANATED THRETED MIRE NETTING WITH A MANUAL PROPERTY OF THE PROPERTY

SECURE THE GWEIGH TO THE ADMISSIT GREIGH.

REPROPULTED FOR CHECK DANS SHALL HAVE A D<sub>m</sub> MEDIAN STONE SIZE OF 6°,

THE PARTY PAUL CILLLI OF TORWING MITH THE ROTHER A HABBILL OF 1'-m".

E. ENGORD BURKET, THE PLACED IN THE REPROPULED CHECK DAN TRENCH DOTHIONG
A MANAGUM OF 1'-m" ON BOTH THE WISTROM AND DOWNSTEAM SIZES OF THE REPROPULED CHECK DA

 THE DESC MANAGER SHALL INSPECT CHECK DAMS WEEKLY, DURING AND AFTER ANY STORM EVENT AND MAKE REPAIRS OR CLEAN DUT AS NECESSARY. SUBJECT COMMAND DESIGNED OF CHEST DAYS SAUL BE ROUGHD WITH THE SEDMENT DEPTH UPSTICAN OF CIECK DAYS IN WITHIN 1 OF THE HOSTIF OF THE CREST.


3. CHEST DAYS ARE TO REMAIN IN PLOCE UNITL THE UPSTICAN DISTURBED AREA IS STABILIZED AND GRASS COURS. SPARKED OF THE CONTIT.

A. WHEN CHECK DAMS ARE REMOVED, EXCHANTIONS SHALL BE FILLED WITH SUITABLE COMPACTED BACK FILL. ANY DISTURBIED AREA SHALL BE DRILL SEDIED AND CRIMP MULCHED AND COMERCE WITH EROSION CONSTRUCT IS AMOST THE PROPERTY STREET FOR THE PROPERTY OF THE COUNTY.

RCD REINFORCED CHECK DAM (13)

3. Crushed rock shall be fractured face (all sides) and shall comply with gradation shown on sheet 1  $(1-1/2^2$  minus), recycled concrete meeting this gradation may be useful. WIRE MESH SHALL BE FABRICATED OF 10 GAUGE WIRE TWISTED INTO A MESH WITH A MAJAMUM OPPINING OF 1.0 INCH (COMMONLY TERMED "CHICKEN WIRE"). ROLL WITH SHALL BE 48-INCHES. WIRE MESH SHALL BE SECURED USING "HOG RINGS" OR WIRE TIES AT 6-INCH CENTERS ALONG ALL JOINTS AND AT 2-INCH CENTERS ON ENDS OF BERM.

2. SEDIMENT ACCUMULATED UPSTREAM OF REINFORCED ROCK BERM SHALL BE REMOVED WHEN THE SEDIMENT DEPTH UPSTREAM OF FILTER IS WITHIN 5 INCHES DE THE CREST. 3. REINFORCED ROCK BERMS ARE TO REMAIN IN PLACE UNTIL THE UPSTREAM DISTURBED AREA IS STABILIZED AND GRASS COVER IS APPROVED WHEN REINFORCED ROCK BERINS ARE REMOVED, ANY DISTURBED AREA SHALL BE DRILL SECRED AND CRIMP MULCHED OR OTHERWISE STABILIZED IN A MAINTEEN ARREST OF THE COURT

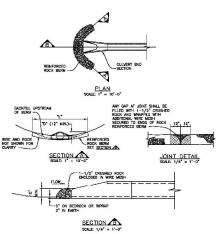


. Crushed rock shall be fractured face (all sides) and shall comply with gradation shown on sheet 1 (1–1/ $2^{\circ}$  minus). Recycled concrete meeting this gradation may be used WIRE MESH SHALL BE FABRICATED OF 10 GAUGE WIRE TWISTED INTO A MESH WITH A MAXIMUM OPENING OF 1.0 INCH (COMMONLY TERMED "CHICKEN WIRE").

1. WINE MEST CIVEL OF SECURED USING "TOO TINGS" OF WINE THE AT 8 INOT SENTENC ALONG A JOINTS AND AT 2-INCH CENTERS ON ENDS OF BERM. . THE ENDS OF THE REINFORCED ROCK BERM SHALL BE 12" HIGHER THAN THE CENTER OF THE BERM

. THE GESC MANAGER SHALL INSPECT CULVERT INLET FILTER WEEKLY, DURING AND AFTER ANY STORM EVENT AND MAKE REPAIRS OR CLEAN OUT AS NECESSARY.

SEDIMENT ACCUMULATED UPSTREAM OF CULVERT INLET PILTER SHALL BE REMOVED WHEN THE SEDIMENT DEPTH UPSTREAM OF FILTER IS \$ THE HEIGHT OF THE REINFORCED ROCK BERM. RRB FOR CULVERT PROTECTION ARE TO REMAIN IN PLACE UNTIL THE UPSTREAM DISTURBED AREA IS STABILIZED AND GRASS COVER IS APPROVED BY THE COUNTY. WHEN CULVERT INLET FILTERS ARE REMOVED, ANY DISTURBED AREA SHALL BE DRILL SEEDED AND CRIMP MULCHED OR OTHERWISE STABILIZED IN A MANNER APPROVED BY THE COUNTY.

RRC RRB FOR CULVERT PROTECTION (15)

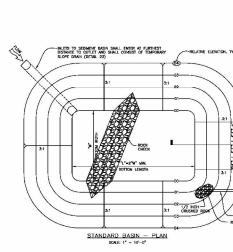


SEDIMENT BASIN INSTALLATION NOTES

MOT: BRITT. REPRESENTATION TO THE PROPERTY FINANCE OF THE OF THE OTHER PROPERTY FINANCE OF THE OTHER PROPERTY FINANCE OF THE OTHER CONTROL OTH

2. FOR STANDARD BASIN, BOTTON DIMENSION MAY BE MODIFIED AS LOW AS BOTTOM AREA IS NOT REDUCED.

3. SEDIMENT BASINS INDICATED ON INITIAL GESC PLAN SHALL BE INSTALLED PRIOR TO ANY OTHER
LINES—DISTRIBUTION ACTIVITY.

EMBANGMENT MATERIAL SHALL CONSIST OF SOIL FREE OF DEBRIS, ORGANIC MATERIAL, AND ROCKS OR CONCRETE ORGANIC THAN 3 INCHES AND SHALL HAVE A MINIMUM OF 15 PERCENT BY WEIGHT PASSING THE UNITED SERVER. EMBANKMENT MATERIAL SHALL BE COMPACTED TO AT LEAST 95 PERCENT OF MAXIMUM DENSITY WITHIN 2
PERCENTAGE POINTS OF OPTIMUM DENSITY IN ACCORDANCE WITH ASTM DESS.

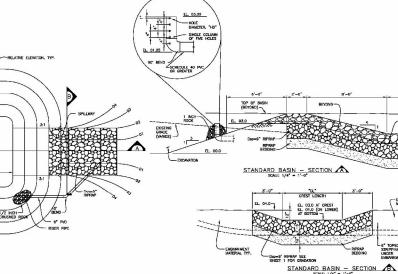

PINLET PROTECTION (12)

DIT BASIN MAINTENANCE MITTES.

THE OESC MANAGES PAUL INSPECT SEDIMENT BASIN WEEKLY, DURING AND AFTER ANY STORM EVENT AND MIKE REPAIRS OR CLEAN OUT AS INDECESSARY.

2. SEDMENT SHALL BE REMOVED FROM THE POND ONCE IT REACHES 1 FOOT IN DEPTH OR 20% OF THE PONDS WATER COALITY CAPTURE VOLUME, WHICEVER IS LESS.

SEDIMENT BASINS ARE TO REMAIN IN PLACE UNTIL THE UPSTREAM DISTURBED AREA IS STABILIZED AND GIMSS COVER IS APPROVED BY THE COUNTY.

SB SEDIMENT BASIN (16)



DEPARTMENT OF PUBLIC WORKS AND DEVELOPMENT — ENGINEERING SERVICES DIVISION

GESC GRADING, EROSION, AND SEDIMENT CONTROL

**GESC PLAN** STANDARD NOTES AND DETAILS JANUARY 2005. REVISED JANUARY 2010

SHEET 2 OF 3

MULLER MEC PROJECT No. 08025.02

Arapahoe

MULLER ENGINEERING CO., INC. CONSULTING ENGINEERS

1RONGATE 4, SUITE 100 777 S. WADSWORTH BLVD LAKEWOOD, COLORADO 80226


PREPARED FOR:

CHERRY CREEK BASIN WATER QUALITY AUTHORITY 8390 E. CRESCENT PKWY., SUITE 500 GREENWOOD VILLAGE, CO. 80111

**MOUNTAIN & LAKE LOOP** SHORELINE STABILIZATION **CHERRY CREEK BASIN WATER QUALITY AUTHORITY** 

**GESC DETAILS** 

JULY 2011 EC-7 33 OF 34

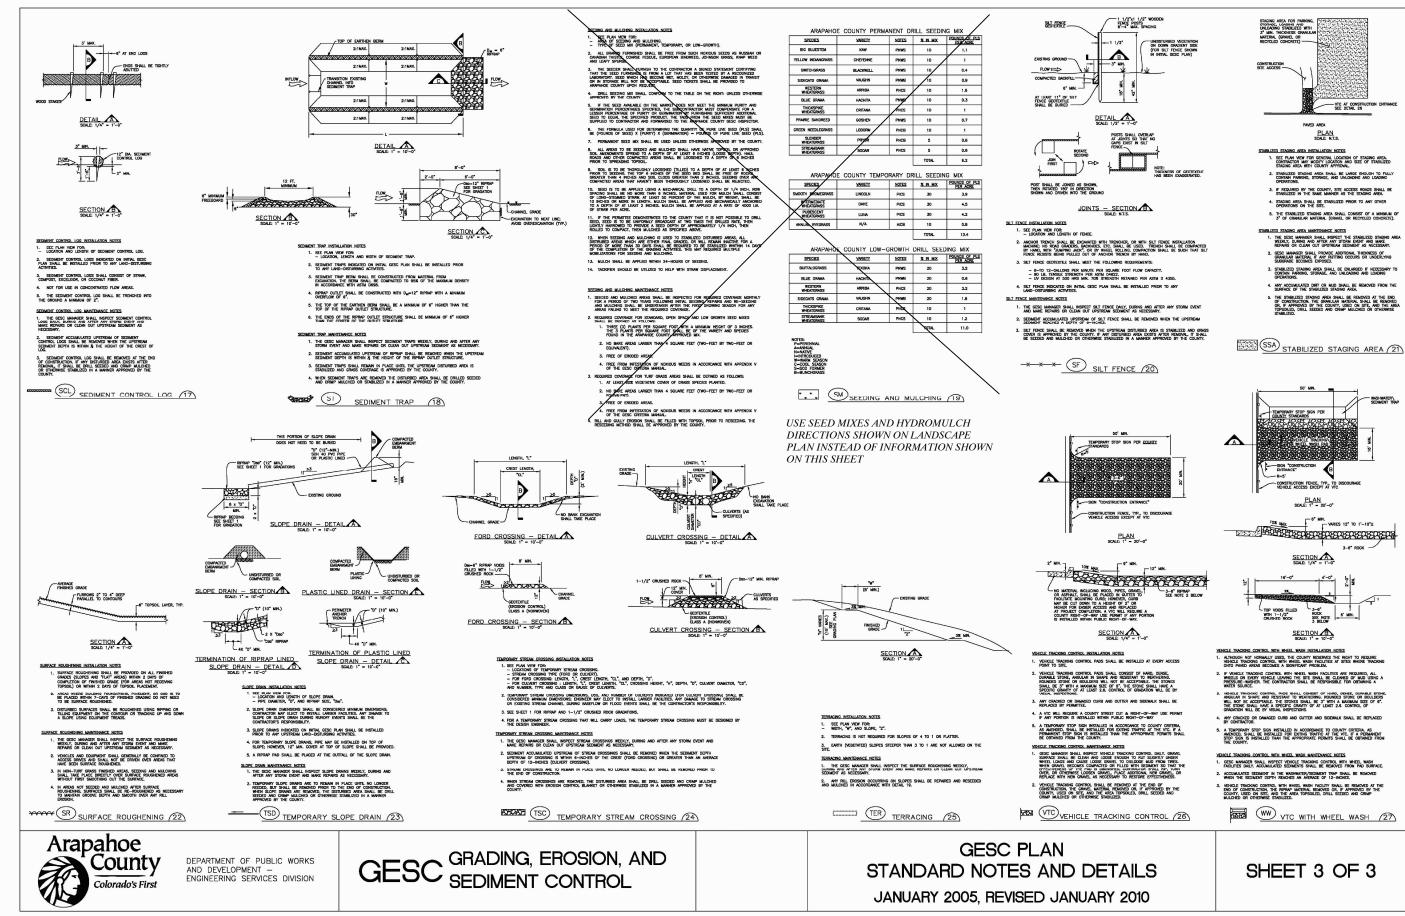

7/2012 FIELD CONDITIONS PRIOR TO BID ALM MULLER

APPR. MEC PROJECT No. 08025.02

### MULLER ENGINEERING CO., INC. CONSULTING ENGINEERS

777 S. WADSWORTH BLVI LAKEWOOD, COLORADO 80226 (303) 988-493

PREPARED FOR

MDC

DRAWN

ALM

CHECK JTW

CHERRY CREEK BASIN WATER QUALITY AUTHORITY 8390 E. CRESCENT PKWY., SUITE 500 GREENWOOD VILLAGE, CO. 80111

**MOUNTAIN & LAKE LOOP SHORELINE STABILIZATION CHERRY CREEK BASIN WATER QUALITY AUTHORITY**  **GESC DETAILS** 

JULY 2011 EC-8